


T. 36 S., R. 7 W., W. M.

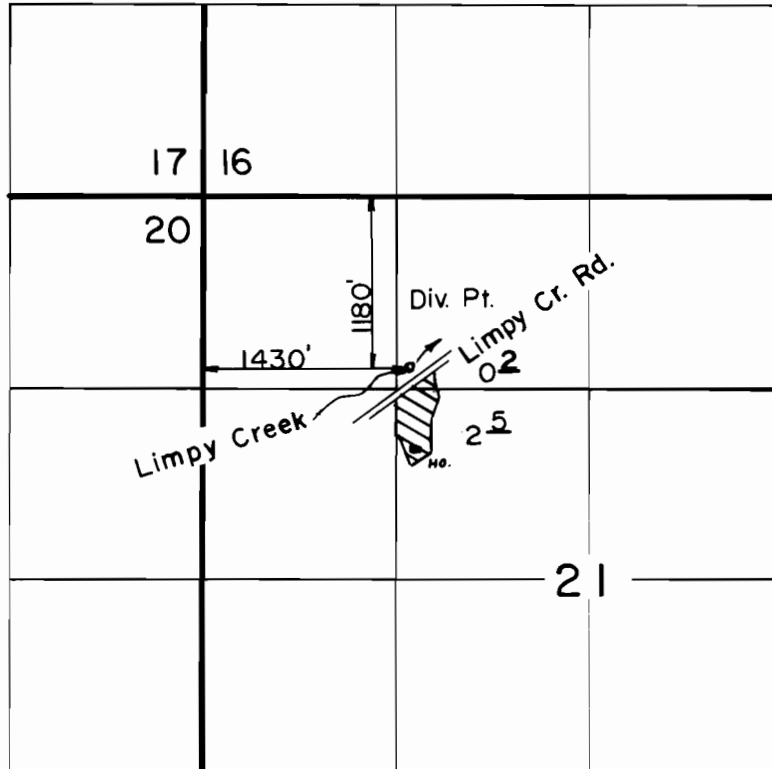

Scale: 1" = 1320'

**FINAL PROOF SURVEY**  
UNDER

Application No. 54623. Permit No. 40985...  
IN NAME OF

GORDON & SUSAN LONGHURST

Surveyed SEP. 1. 1988, by B. S. JAMES...

