


T. 38 S., R. 6 W., W. M.

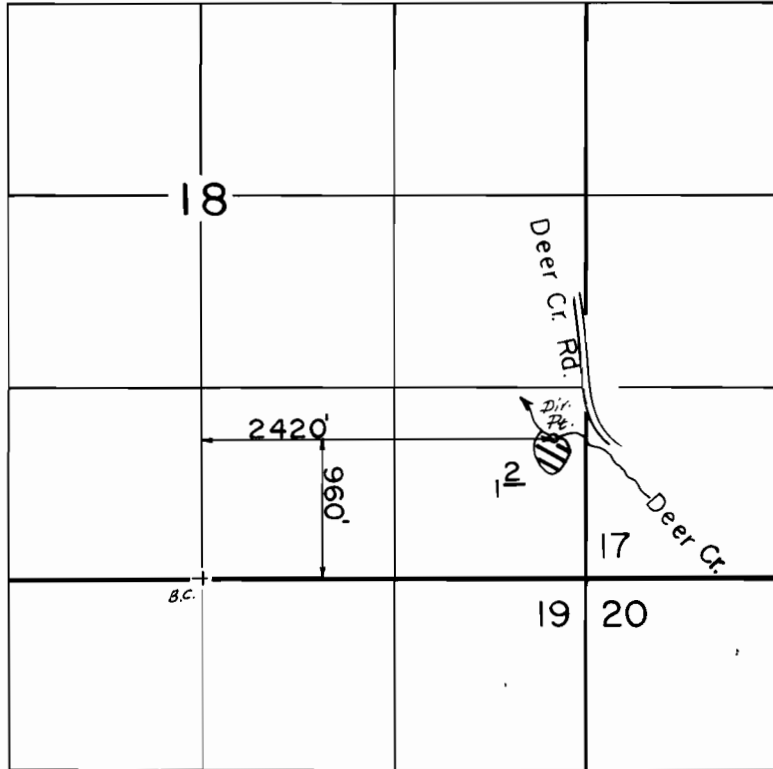

Scale: 1" = 1320'

FINAL PROOF SURVEY
UNDER

Application No. 54672 Permit No. 41021....
IN NAME OF

.....JAMES C. SLOAN.....

Surveyed MAY 23, 1988, by B. S. JAMES.....