


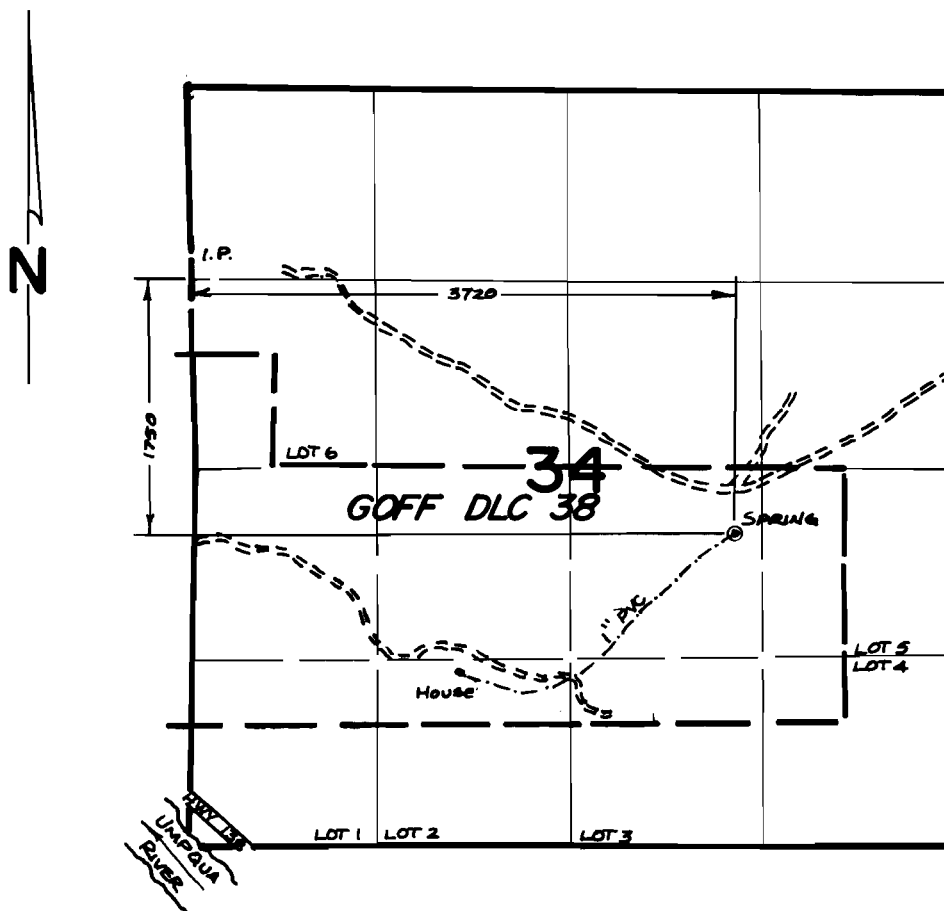

SCALE : 4" = 1 MILE

FINAL PROOF SURVEY

UNDER

Application No. ...55115.. Permit No.41390....
IN NAME OF

.....EDJON.....CORPORATION.....

Surveyed ...8/25.... 19.87., by ...M...SCHMORDE..