


T. 40 S., R. 14 W., W.M.

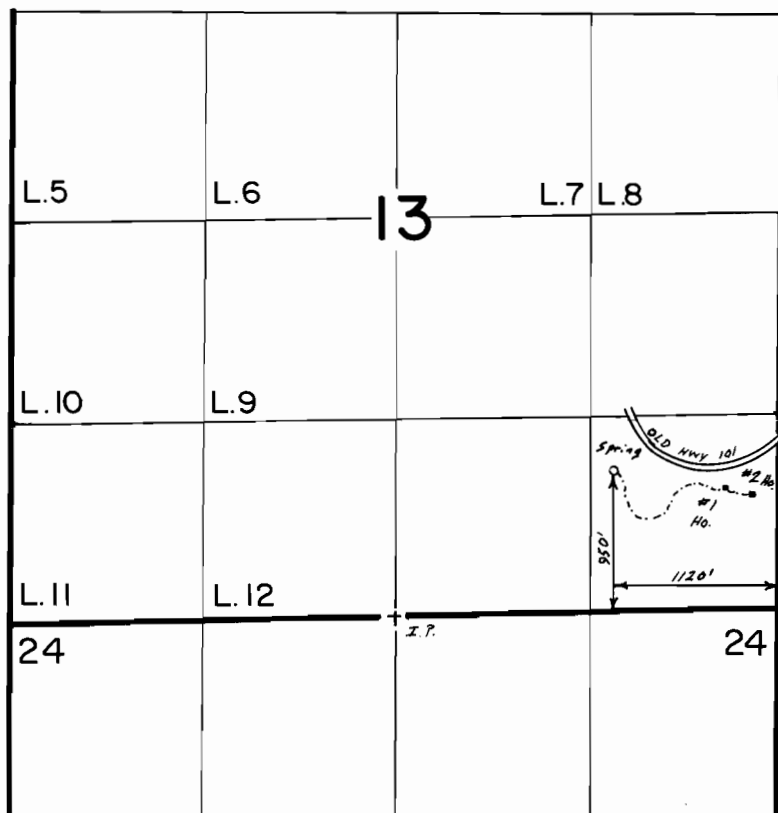

Scale 4" = 1 Mile

FINAL PROOF SURVEY

UNDER

Application No. 55440 Permit No. 42222
IN NAME OF

KARL OSTENBERG

Surveyed Oct. 14 1987, by L.M. JOACHIMS