


T. 3S., R. 3W., W.M.

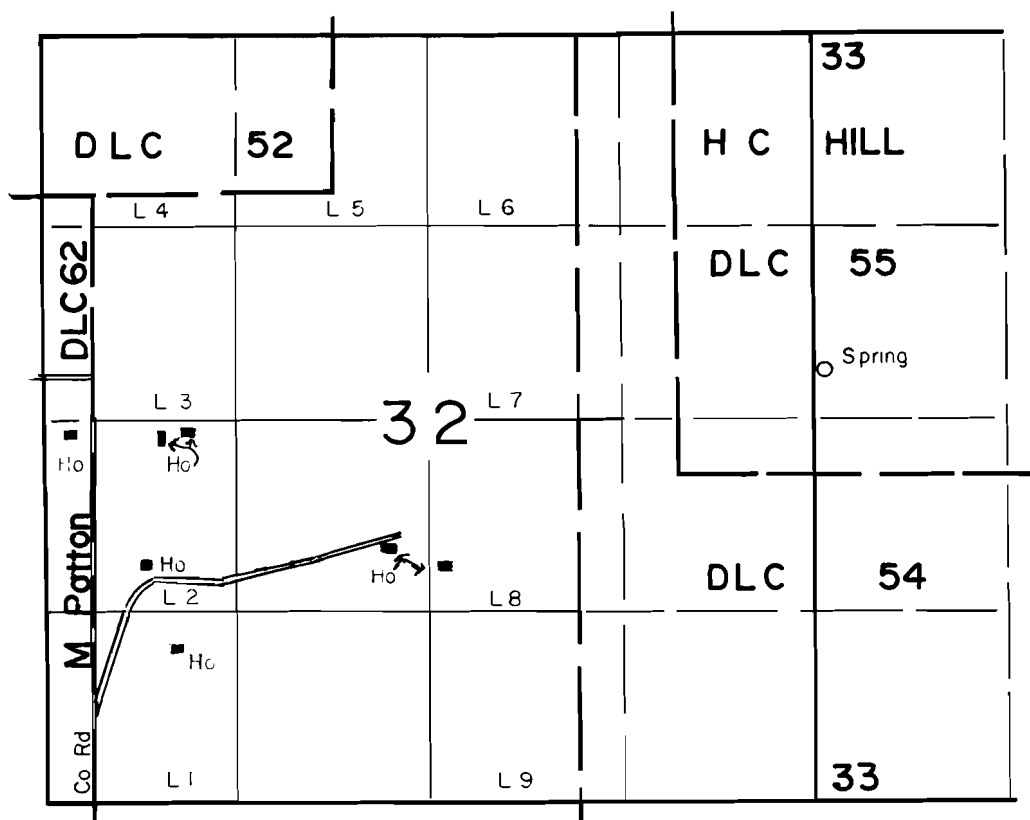

Spring Located 320' N & 80' E From The W 1/4 Corner Of Section 33

SCALE: 1" = 1320'

FINAL PROOF SURVEY UNDER

Application No. 55690... Permit No. 42761.....
IN NAME OF

BLUEBIRD VALLEY WATER COOPERATIVE

Surveyed MAY 31 1989, by T. M. WARREN.....