


T.2S., R.2E.,W.M.

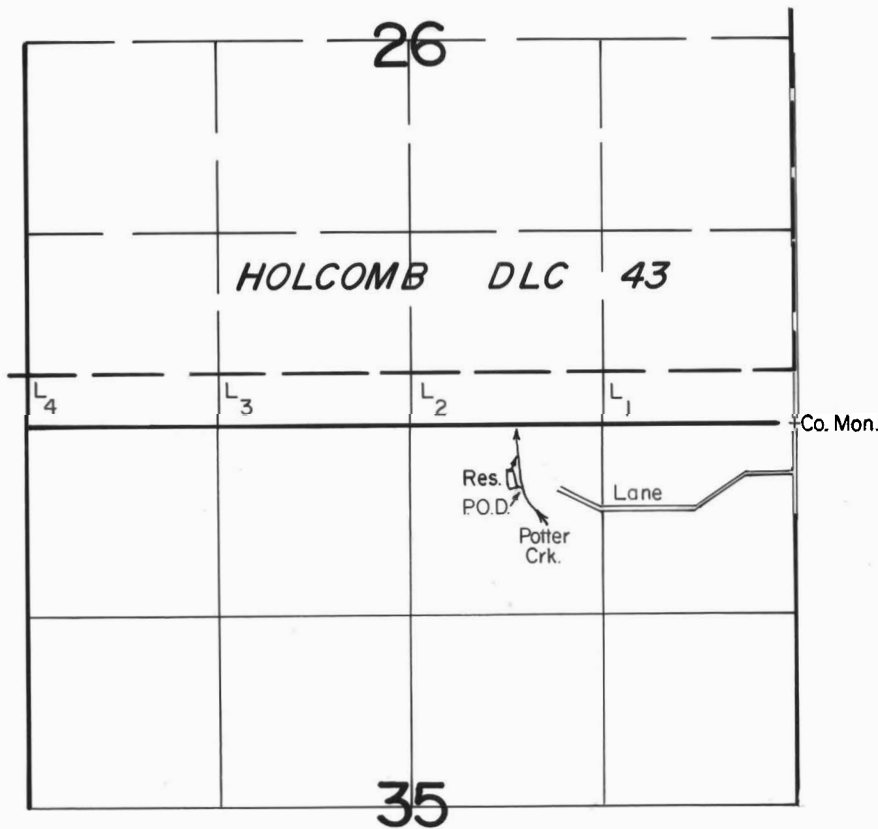

Dam P.O.D. Loc: 450' S. & 1880' W. from NE Cor. Sec. 35.

Scale: 1" = 1320'

FINAL PROOF SURVEY
UNDER

R-59013 R-7969
Application No. 59014 Permit No. 44560
IN NAME OF

DOUGLAS NICHOLSON / GRACE McLAUGHLIN

Surveyed AUG. 19 1986., by J. Warren

PTS-1986-C
#1005-278-98L
TMW 2/11/87