


T.15S.,R.5W.,W.M.

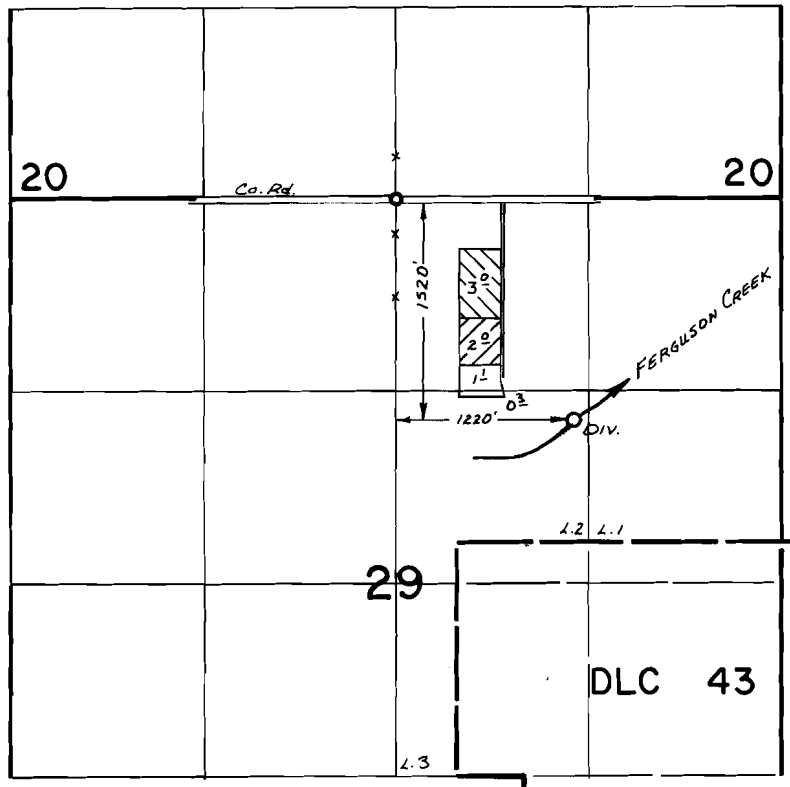

FINAL PROOF SURVEY
UNDER

Transfer No. 4466
Application No. 59911 Permit No. 45019 
IN NAME OF

.....JERRY H. MOFFETT.....

Surveyed Sept. 17, 1981, by S. C. BROWN.....