


T. 1N., R. 38E., W. M.

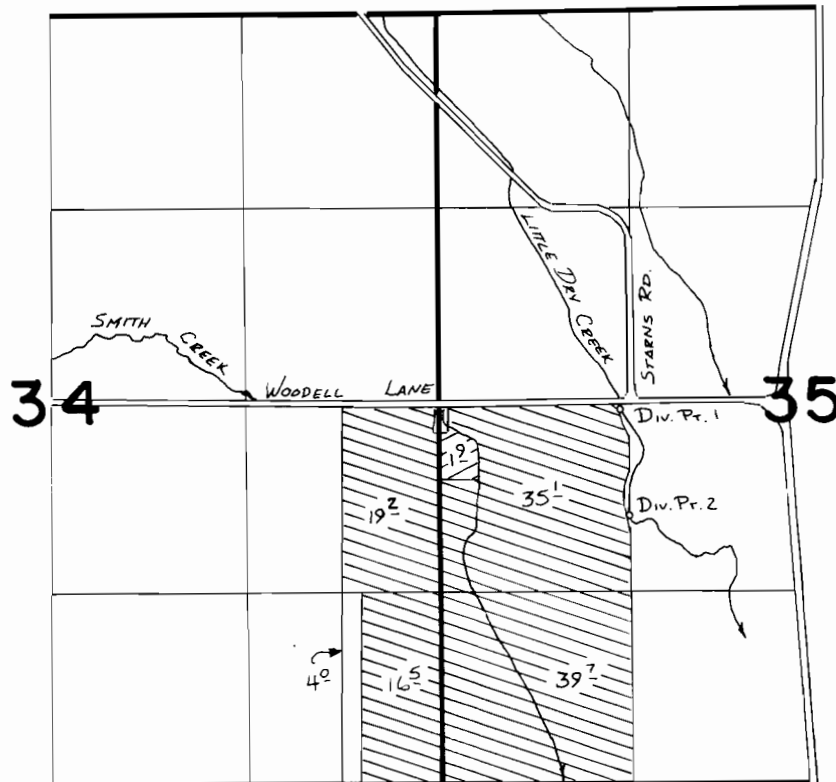

SCALE 1" = 1320

Div. Pt. 1 Loc: 60'S. & 1240'E. } FROM W 1/4 COR. SEC. 35
 Div. Pt. 2 Loc: 800'S. & 1300'E }



PRIM



SUPP'L

FINAL PROOF SURVEY UNDER

Application No. **59921** Permit No. **46448**
 IN NAME OF

KENNETH R. M^CCOY

Surveyed 4-2-1987, by V. L. Church