


T. 35 S.
R. 3 W., W.M. R. 2 W., W.M.

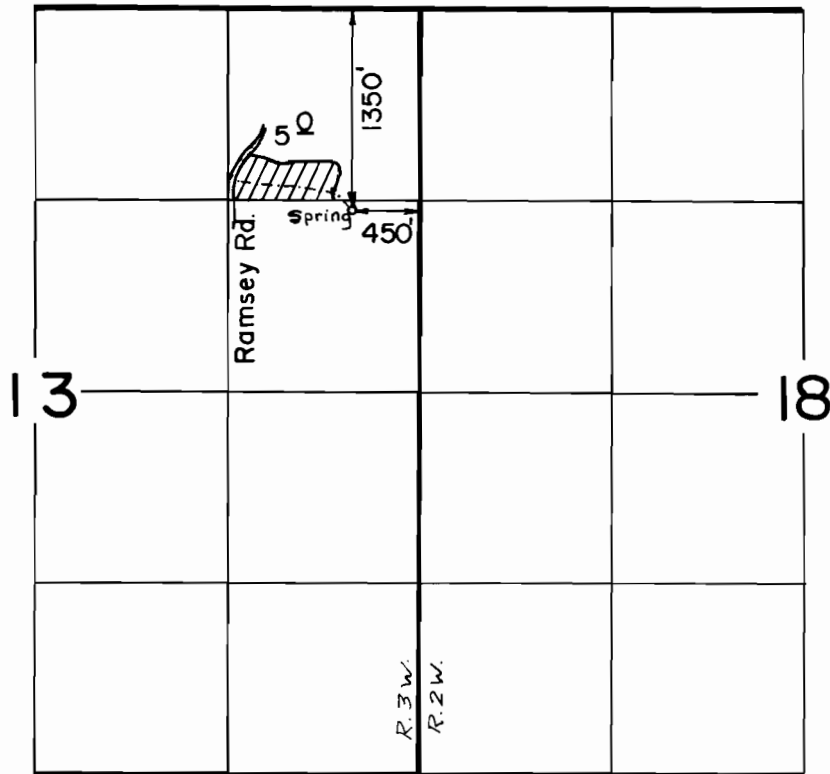

Scale: 1" = 1320'

FINAL PROOF SURVEY UNDER

Application No. 60082 Permit No. 45690...
IN NAME OF

MR. LAURI ONJUKKA

Surveyed JUN. 8. 1987, by R. S. JAMES...