


T. 7N., R. 4W., W.M.

Sec. 16

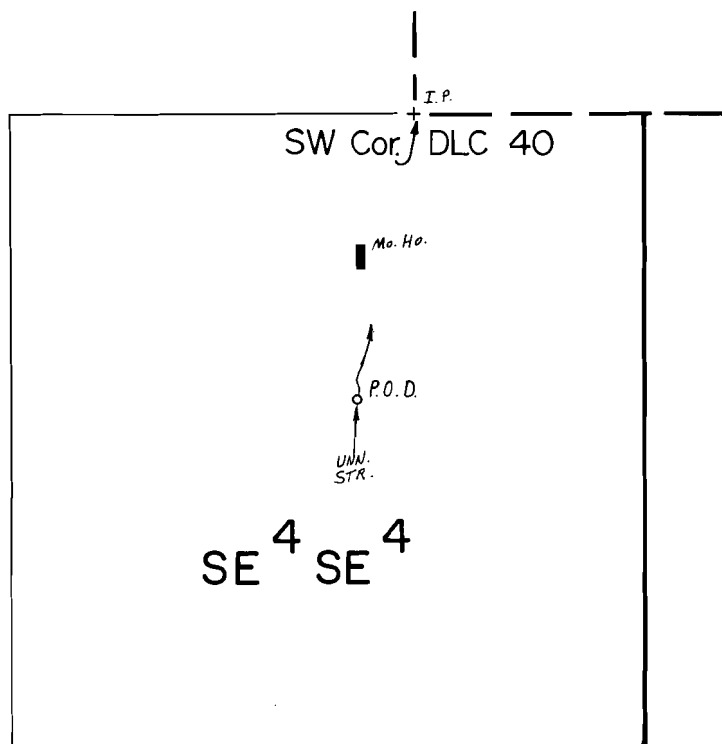

P.O.D. Loc.: 595' S. & 120' W. from SW Cor. Z. Bryant DLC 40.

Scale: 1" = 400'

FINAL PROOF SURVEY

UNDER

Application No. 60100.... Permit No. 45851.....

IN NAME OF

MICHAEL W. & LOUISE M. DOOLITTLE

Surveyed AUG. 12. 1986, by T. Warren.....

PTS-1986-C
TMW 1/12/87