


T. 36 S., R. 5 W., W. M.

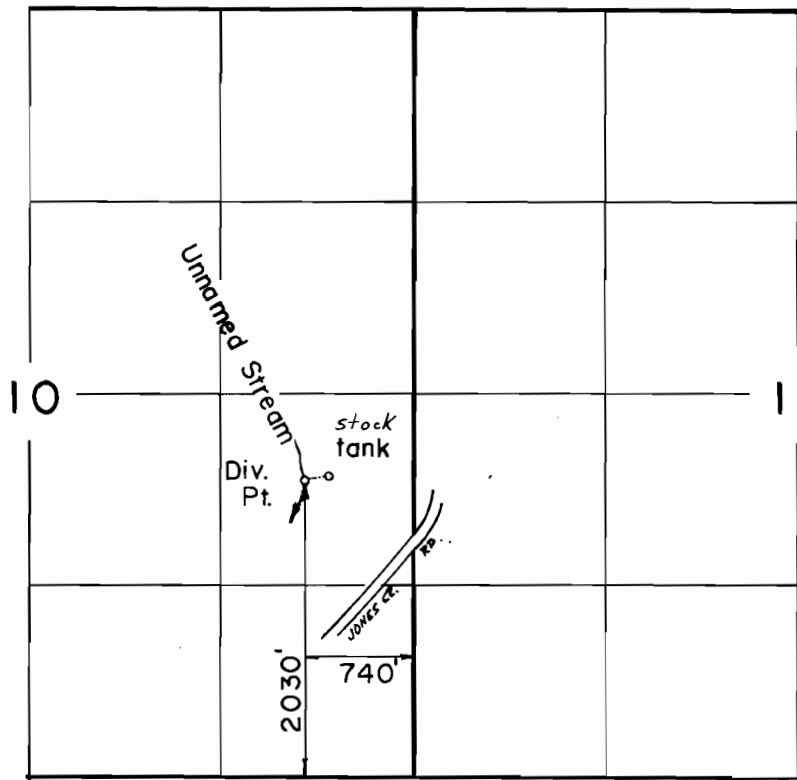

Scale: 1" = 1320'

FINAL PROOF SURVEY

UNDER

Application No. 60257 Permit No. 45533...

IN NAME OF

ALFONSE L. FAMOSO
.....CECELIA.....E.....FAMOSO.....

Surveyed JUL 8 1987, by B. S. JAMES.....