


T.25S., R.7W., W.M.

SECTION 16 & 21

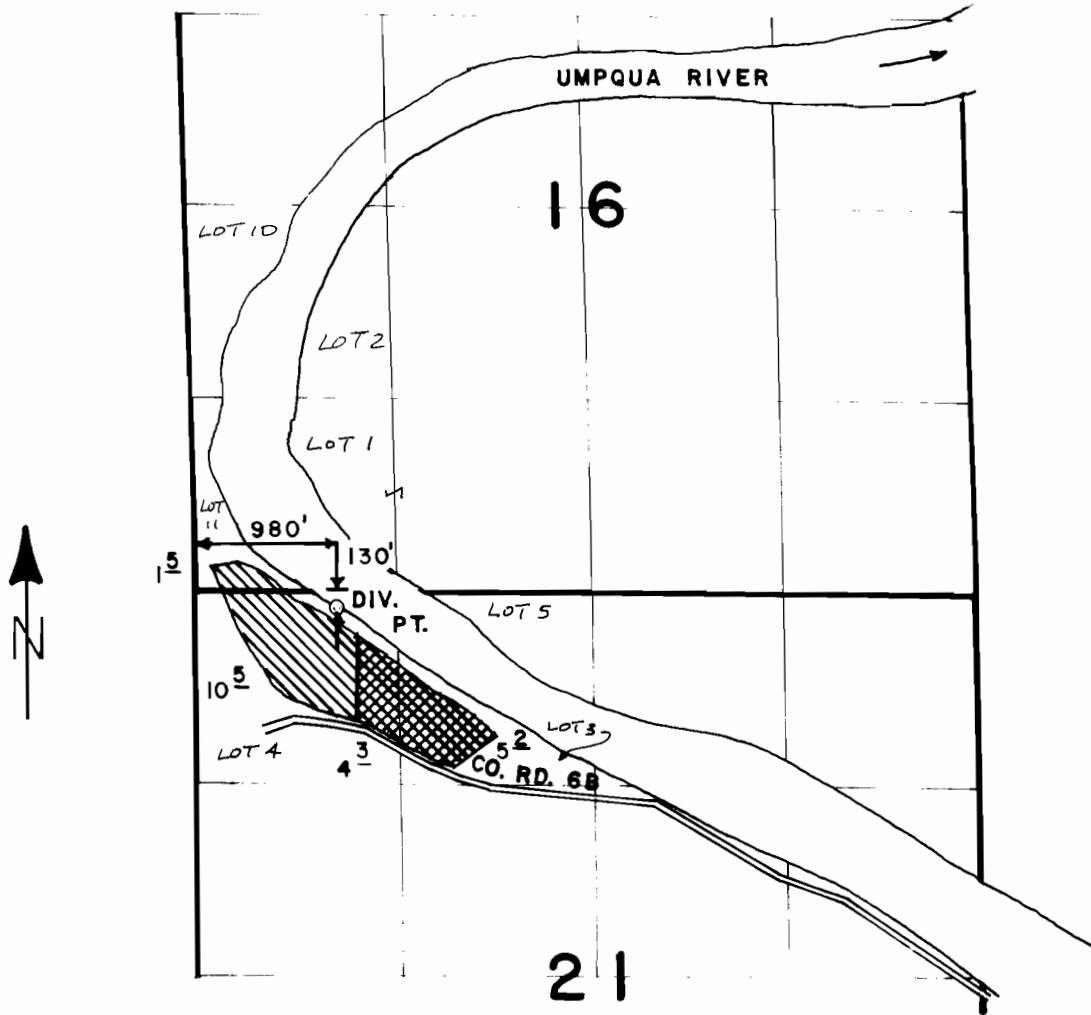

SCALE: 4" = 1 MILE

FINAL PROOF SURVEY UNDER

66413	48082	
Application No. 60321	Permit No. 45541	

IN NAME OF

H. B. AND MELBA L. GERMOND

Surveyed OCT. 13, 1987, by J. M. SCHMORDE