




T. 35 S., R. 6 W., W.M.

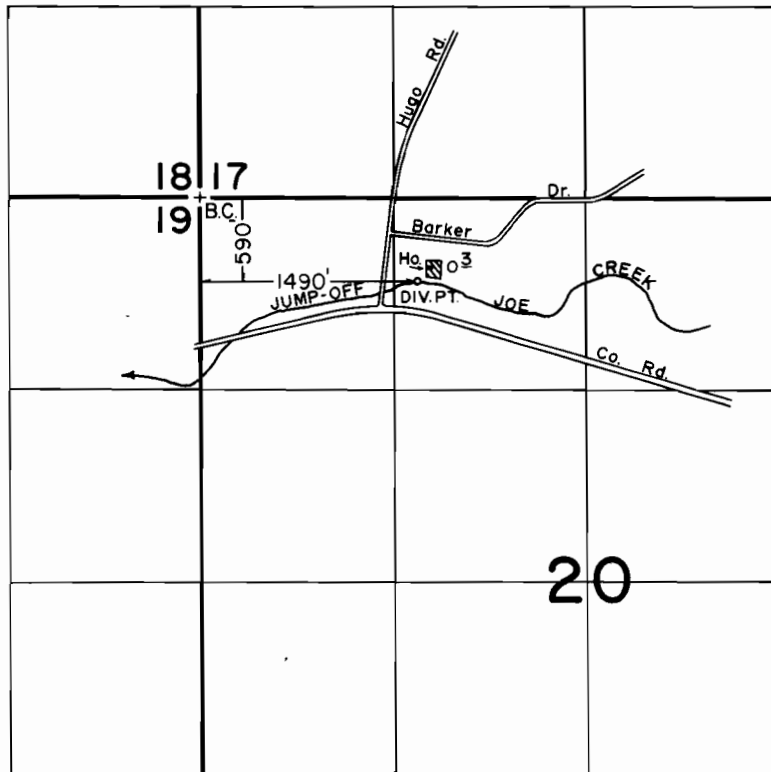

SCALE: 1" = 1320'

FINAL PROOF SURVEY
UNDER

Application No. 60328... Permit No. 46288.....
IN NAME OF

CHARLES HENNING PETERSEN

Surveyed MAY 15... 1989, by B. S. JAMES.....