


T. 37 S., R. 5 W., W.M.

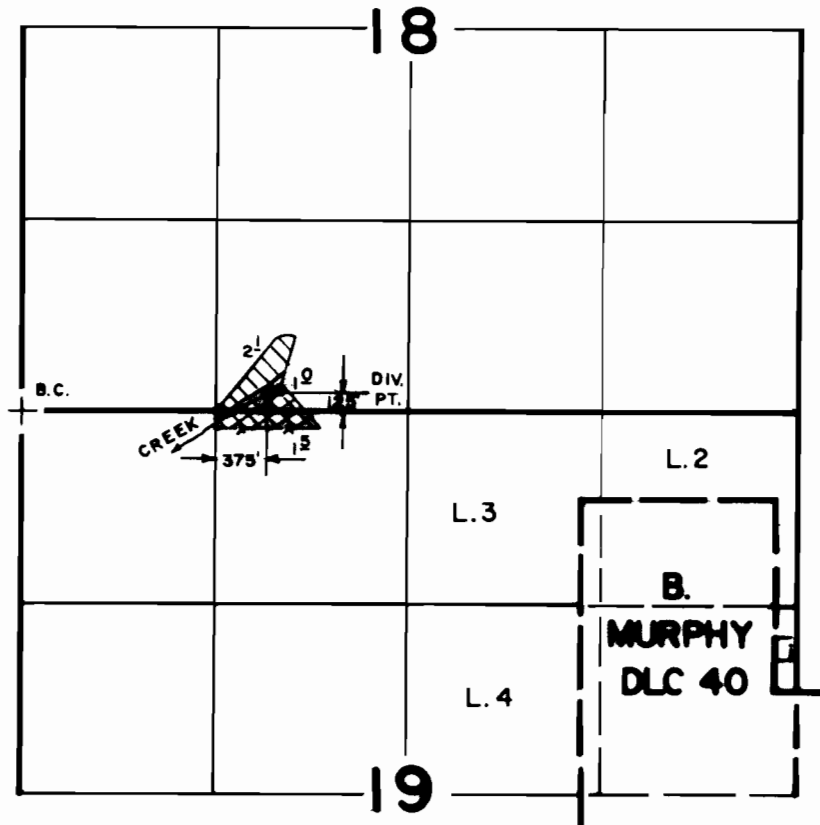

FINAL PROOF SURVEY
UNDER

Application No. **60429** Permit No. **46186**.....
IN NAME OF

.....**CLAUDE VEST**.....

Surveyed **SEPT. 28 19.83**, by **B. SUZIE JAMES**.

SCALE: 4" = 1 MILE

PRIMARY

SUPPLEMENTAL