


# T. 36 S., R. 6 W., W. M.

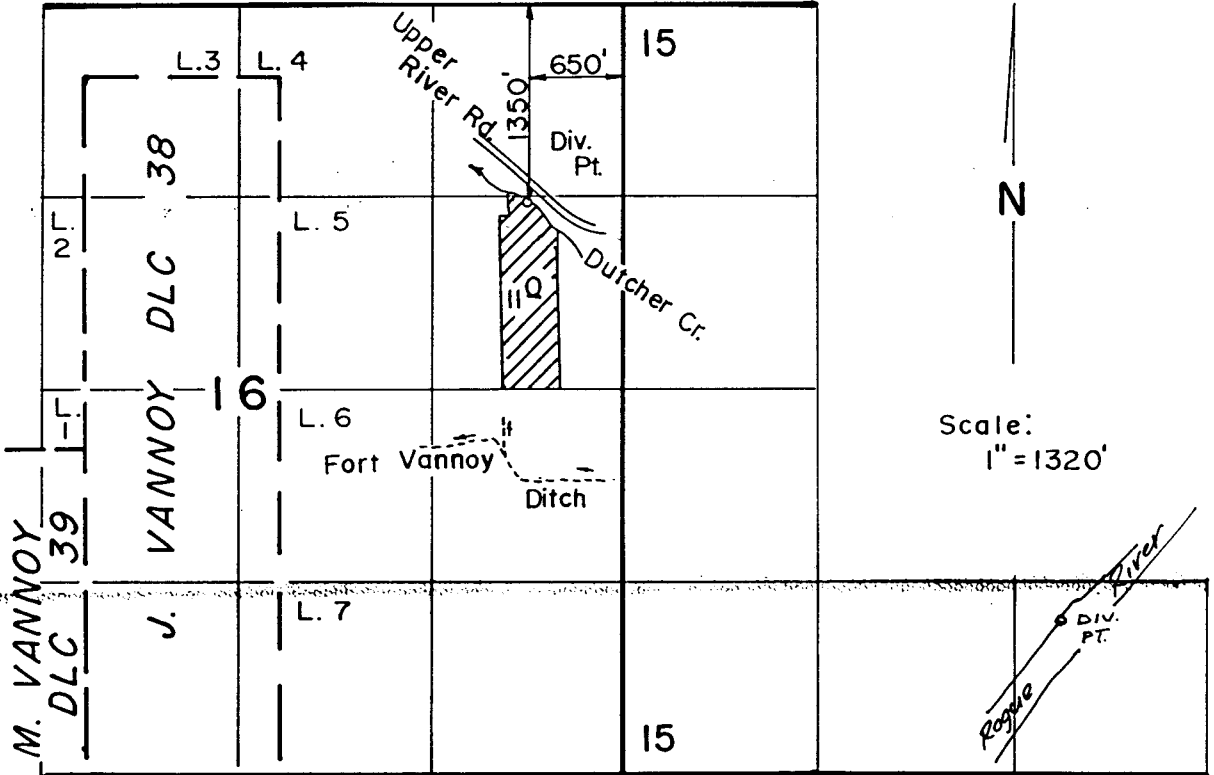

Div. Pt., Ft. Vannoy Irr. Dist. = N. 71° E. 3150' from  
 (T. 36 S., R. 6 W., W. M.) S.W. Cor. of Sec. 15, in  
 S.W. 1/4 S.E. 1/4

RECEIVED

OCT 31 1990

WM. DIST. 14  
GRANTS PASS, ORE.

## FINAL PROOF SURVEY

UNDER

60533                      46006

62988                      46647

Application No. 64546 Permit No. 47238...

IN NAME OF

.....CHARLES K. JENNER.....

Surveyed SEP. 15. 19.8.7. by B. S. JAMES....