


T. 6N., R. 38E., W.M.

SW1/4 SE1/4 SECTION 18

SCALE 1" = 1320

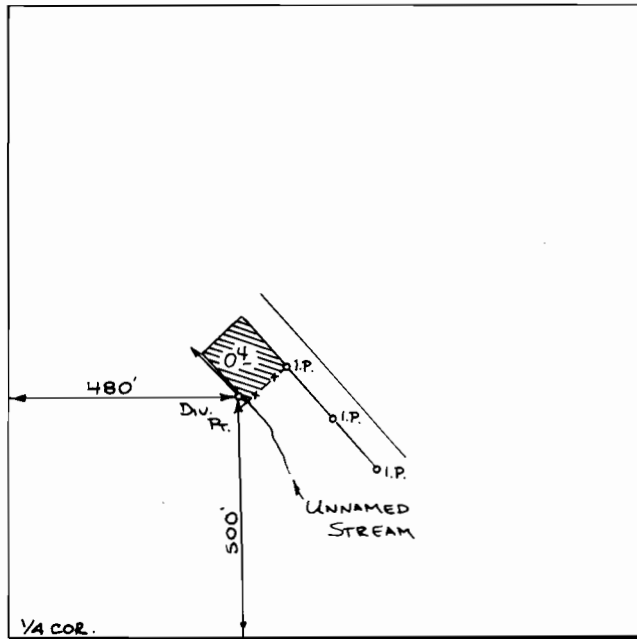

FINAL PROOF SURVEY
UNDER

Application No. **60578** Permit No. **45998**
IN NAME OF

MARCIA B. BAKER

Surveyed ~~4-28~~ 1987, by ~~V.L. Church~~