


T. 35 S.

R. 3 W., W.M.

R. 2 W., W.M.

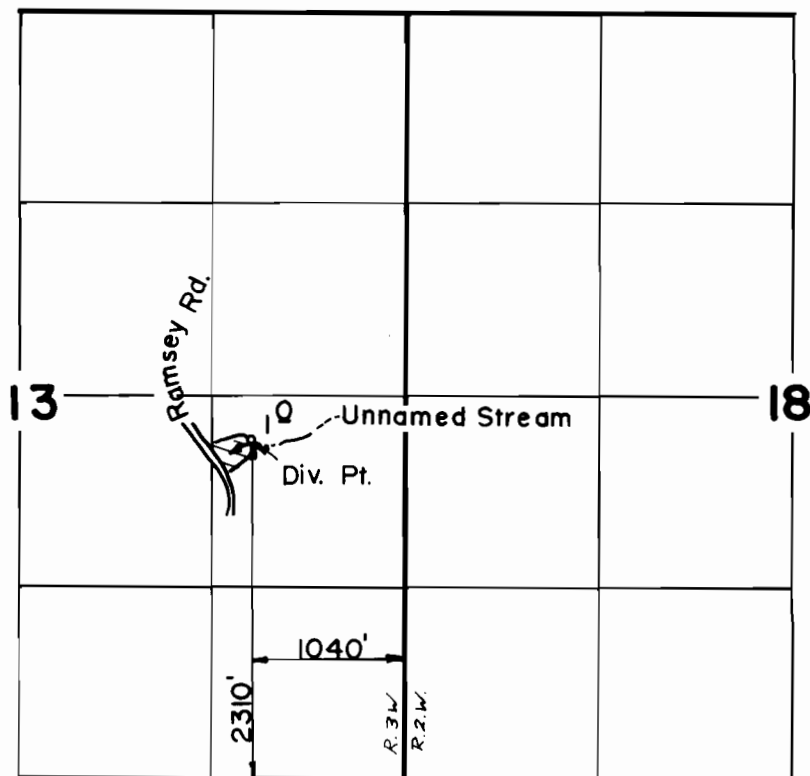

Scale: 1" = 1320'

FINAL PROOF SURVEY

UNDER

Application No. 60587 Permit No. 46008
IN NAME OF

RONALD DALE 8/08 LYNDIA K. OVERSTAKE

Surveyed JUN. 9. 1987, by B. S. JAMES.