


40884

10
6
5

T. 30S., R. 5 W., W.M.

SECTION 33

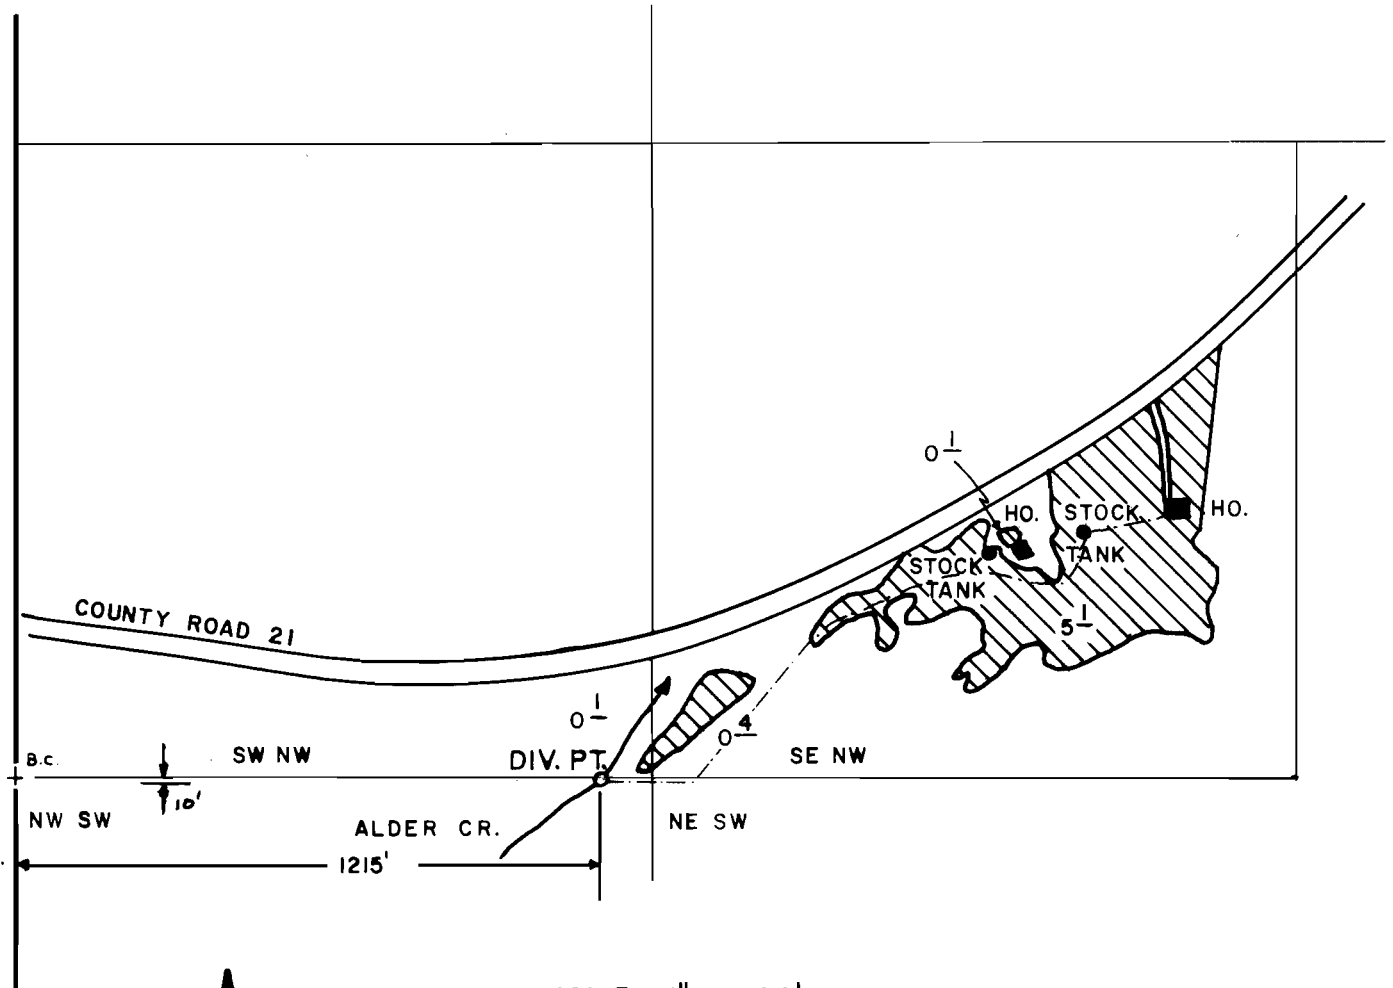

SCALE: 1" = 400'



FINAL PROOF SURVEY UNDER

Application No. 60611..... Permit No. 45768.....
IN NAME OF

CECIL A. WOLFER, JR.

Surveyed JUNE 18, 1986, by J. M. SCHMORDE