


T. 19S., R. 47E., W. M.

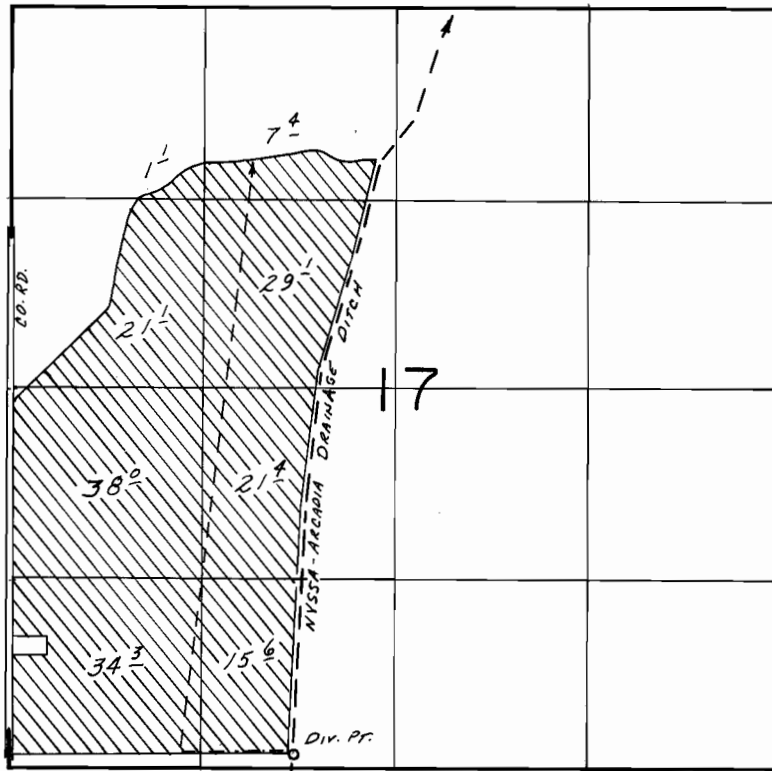

DIV. PT. LOC.: 100' N. & 1950' E. FROM SW COR. SEC. 17.

SCALE: 1" = 1320'

### FINAL PROOF SURVEY UNDER

Application No. 60664. Permit No. 45439.....  
IN NAME OF

.....DICK & LOIS CORN.....

Surveyed Feb. 26... 19.86, by L.M.TOLL.....

2/25/87  
41045-378-203L BMB