


# T. 29S., R. 4W., W.M. SECTION 23

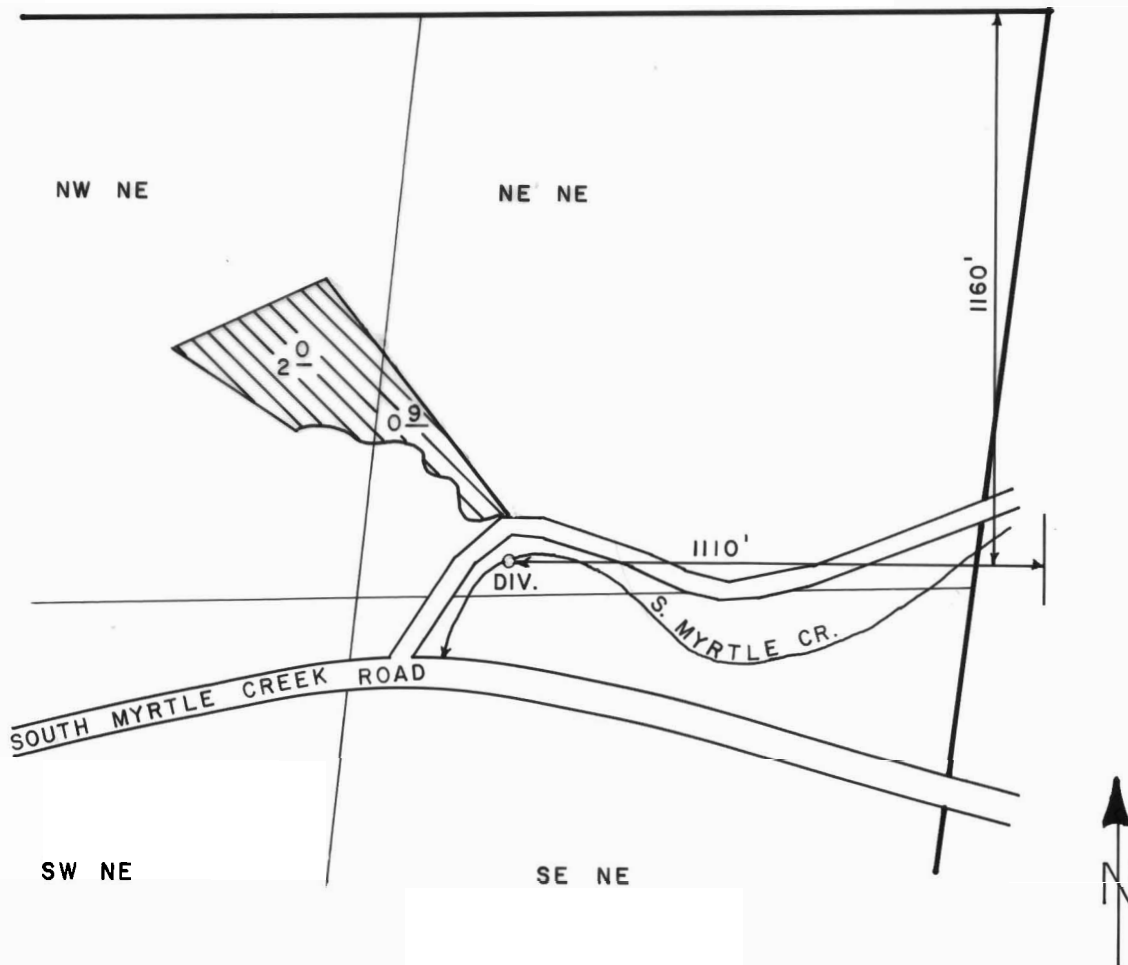

SCALE: 1" = 400'

## FINAL PROOF SURVEY UNDER

Application No. 60670 Permit No. 45394  
IN NAME OF

**ELLA & ROBERT OKAS**

Surveyed MAY 7 1986, by J. M. SCHMORDE