


T. 26 S., R. 5 W., W.M.

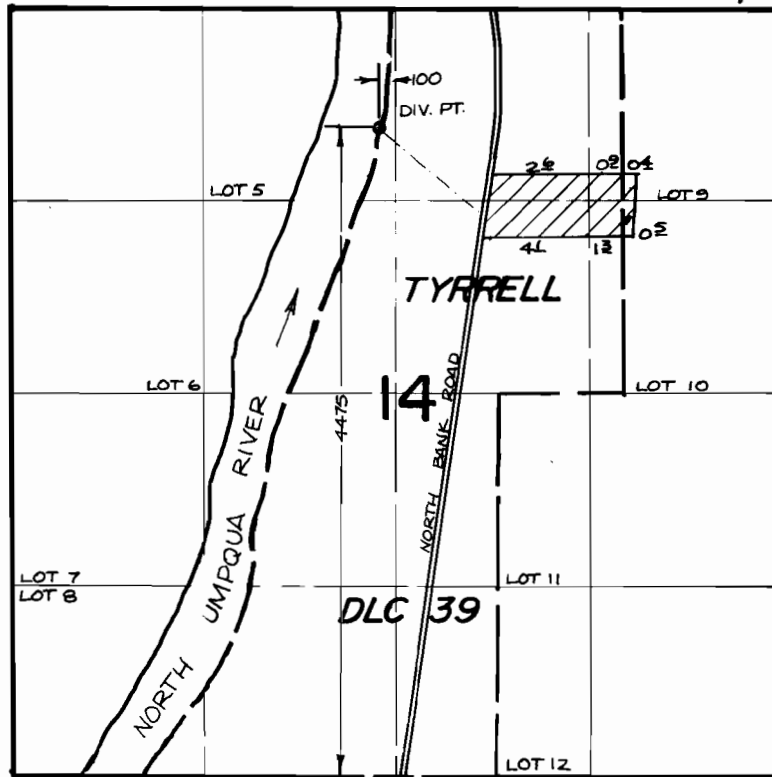

SCALE : 4" = 1 MILE

FINAL PROOF SURVEY UNDER

Application No. ...60854 Permit No. ...45397.....
IN NAME OF

.....DONALD K. ROBINSON.....

Surveyed .JUNE..26, 19.85, by ...J.M..SCHMORDE