


T. 28S., R. 6W., W.M.
SECTION 24

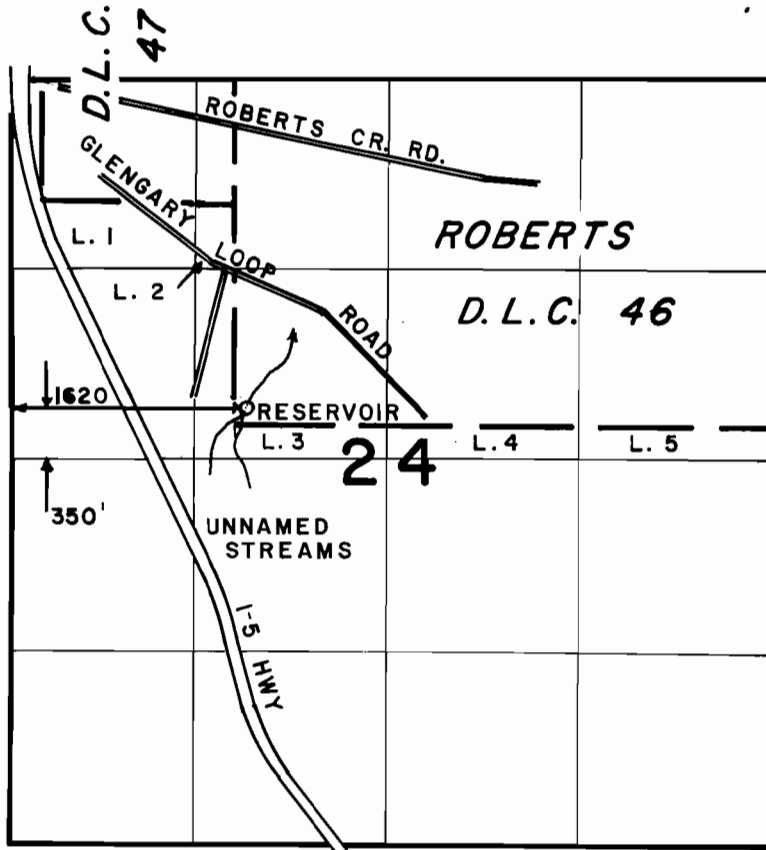

SCALE: 4" = 1 MILE

FINAL PROOF SURVEY
UNDER

Application No. R-60924 Permit No. R-8203
IN NAME OF

EDWARD WEINHOLD

Surveyed MAY 7, 1987, by J. M. SCHMORDE