


# T. 10S., R. 6W., W.M.

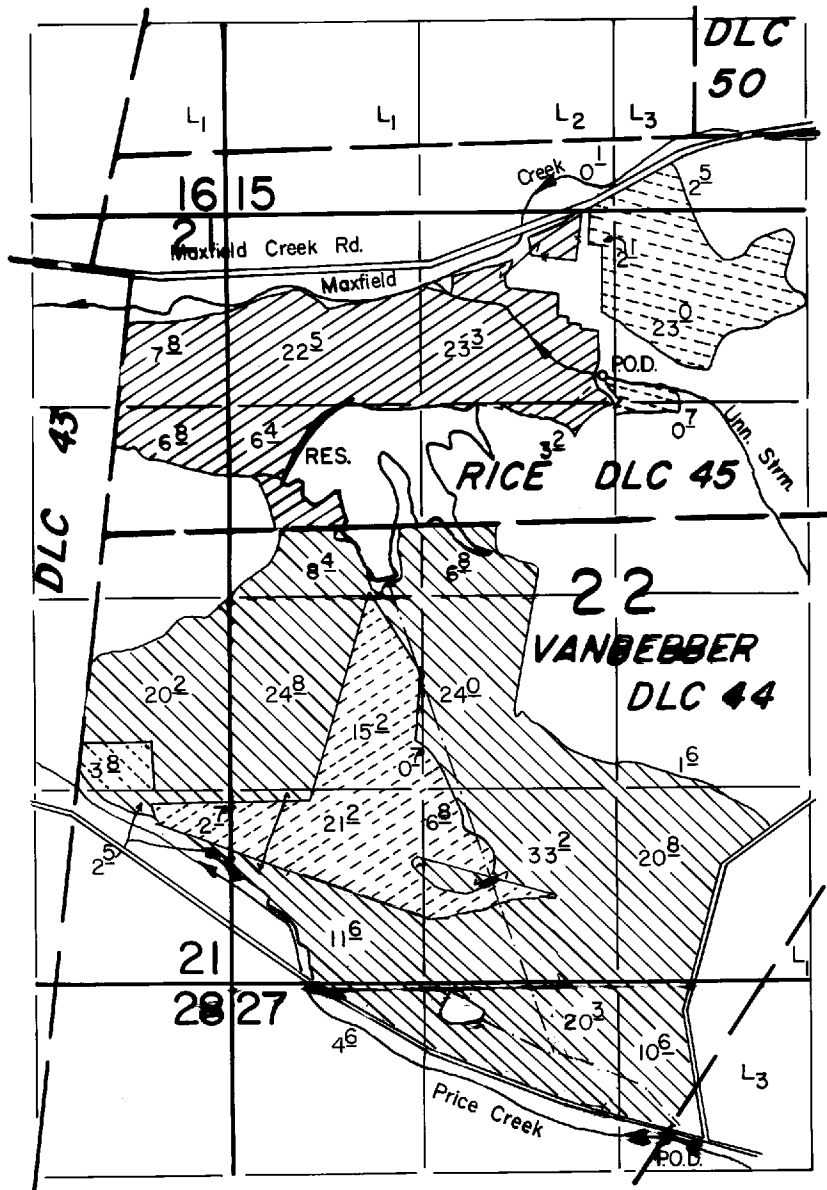

Scale: 1" = 1320'



- Supplemental From Unnamed Stream & Reservoir
- Primary From Unnamed Stream & Price Crk.
- Supplemental From Unnamed Stream only
- Supplemental From Price Creek & Reservoir

Unnamed Stream P.O.D.,  
Loc.: 4170' N. & 2530' E.

Price Crk. P.O.D. Loc.:  
1150' S. & 3130' E.

Res. Loc.:  
3860' N. & 600' E.

All from SW Cor. Sec. 22.

## FINAL PROOF SURVEY UNDER

R-61137

R-8259

Application No. 61138 Permit No. 45703

IN NAME OF

.....  
Surveyed April 23, 1987, by T. Warren.....

*Inspection*  
3/24/89 TAW