





T.7S., R.46E., W.M.

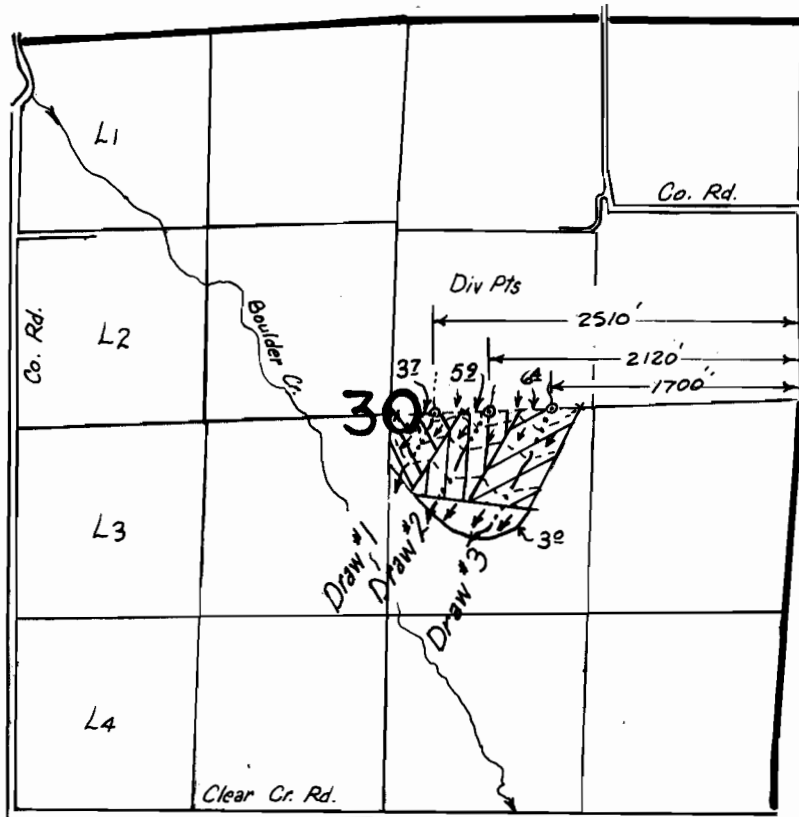

Scale: 1" = 1320'

-  Draw #1 irrigation
-  Draw #2 irrigation
-  Draw #3 irrigation

FINAL PROOF SURVEY UNDER

Application No. 61227 Permit No. 46370
IN NAME OF

ROBERT F. FORTE

Surveyed 10-3 1988, by Kenn Kemp