




T. 13 S., R. 20 E., W.M.

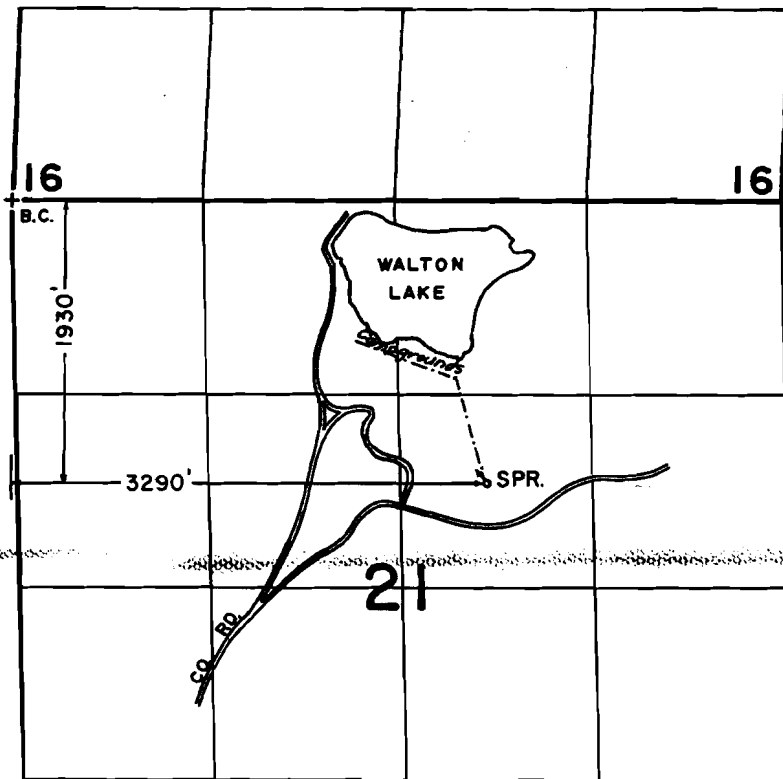

SCALE: 1" = 1320'

**FINAL PROOF SURVEY**  
UNDER

Application No. 62696 Permit No. 48861....  
IN NAME OF

U.S. OCHOCO NATIONAL FOREST

Surveyed APRIL 6, 1990., by J.H. CAREY...

*Certificate 64839*

5-31-90 *gc*

41013-280-222 A

48861