


T. 27 S., R. 5 W., W. M.

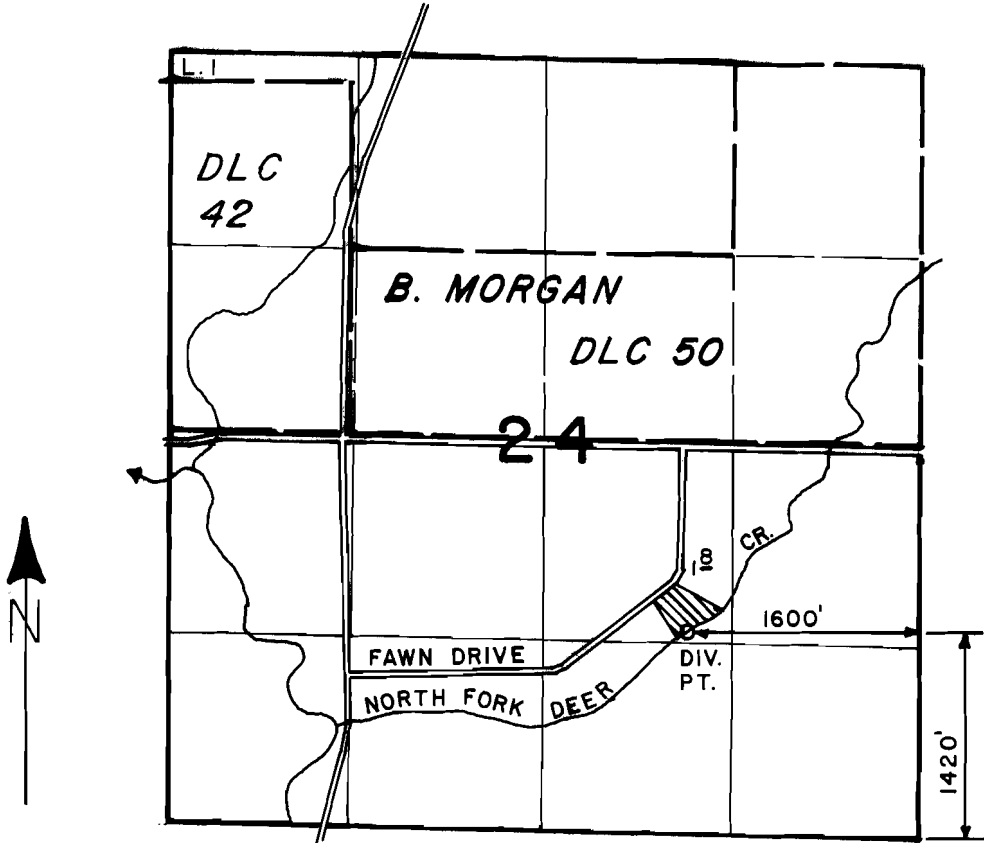

SCALE: 4" = 1 MILE

FINAL PROOF SURVEY
UNDER

Application No. 63790 Permit No. 46954
IN NAME OF

KENNETH J. BEEBE

Surveyed OCT. 23, 1987, by J.M. SCHMORDE