


WILLAMETTE NATIONAL FOREST BOUNDARY

ALL LANDS PROPERTY OF U.S.F.S.

DIVERSION POINT LOCATED: 1520 feet North and 660 feet West from the SE corner of Section 30

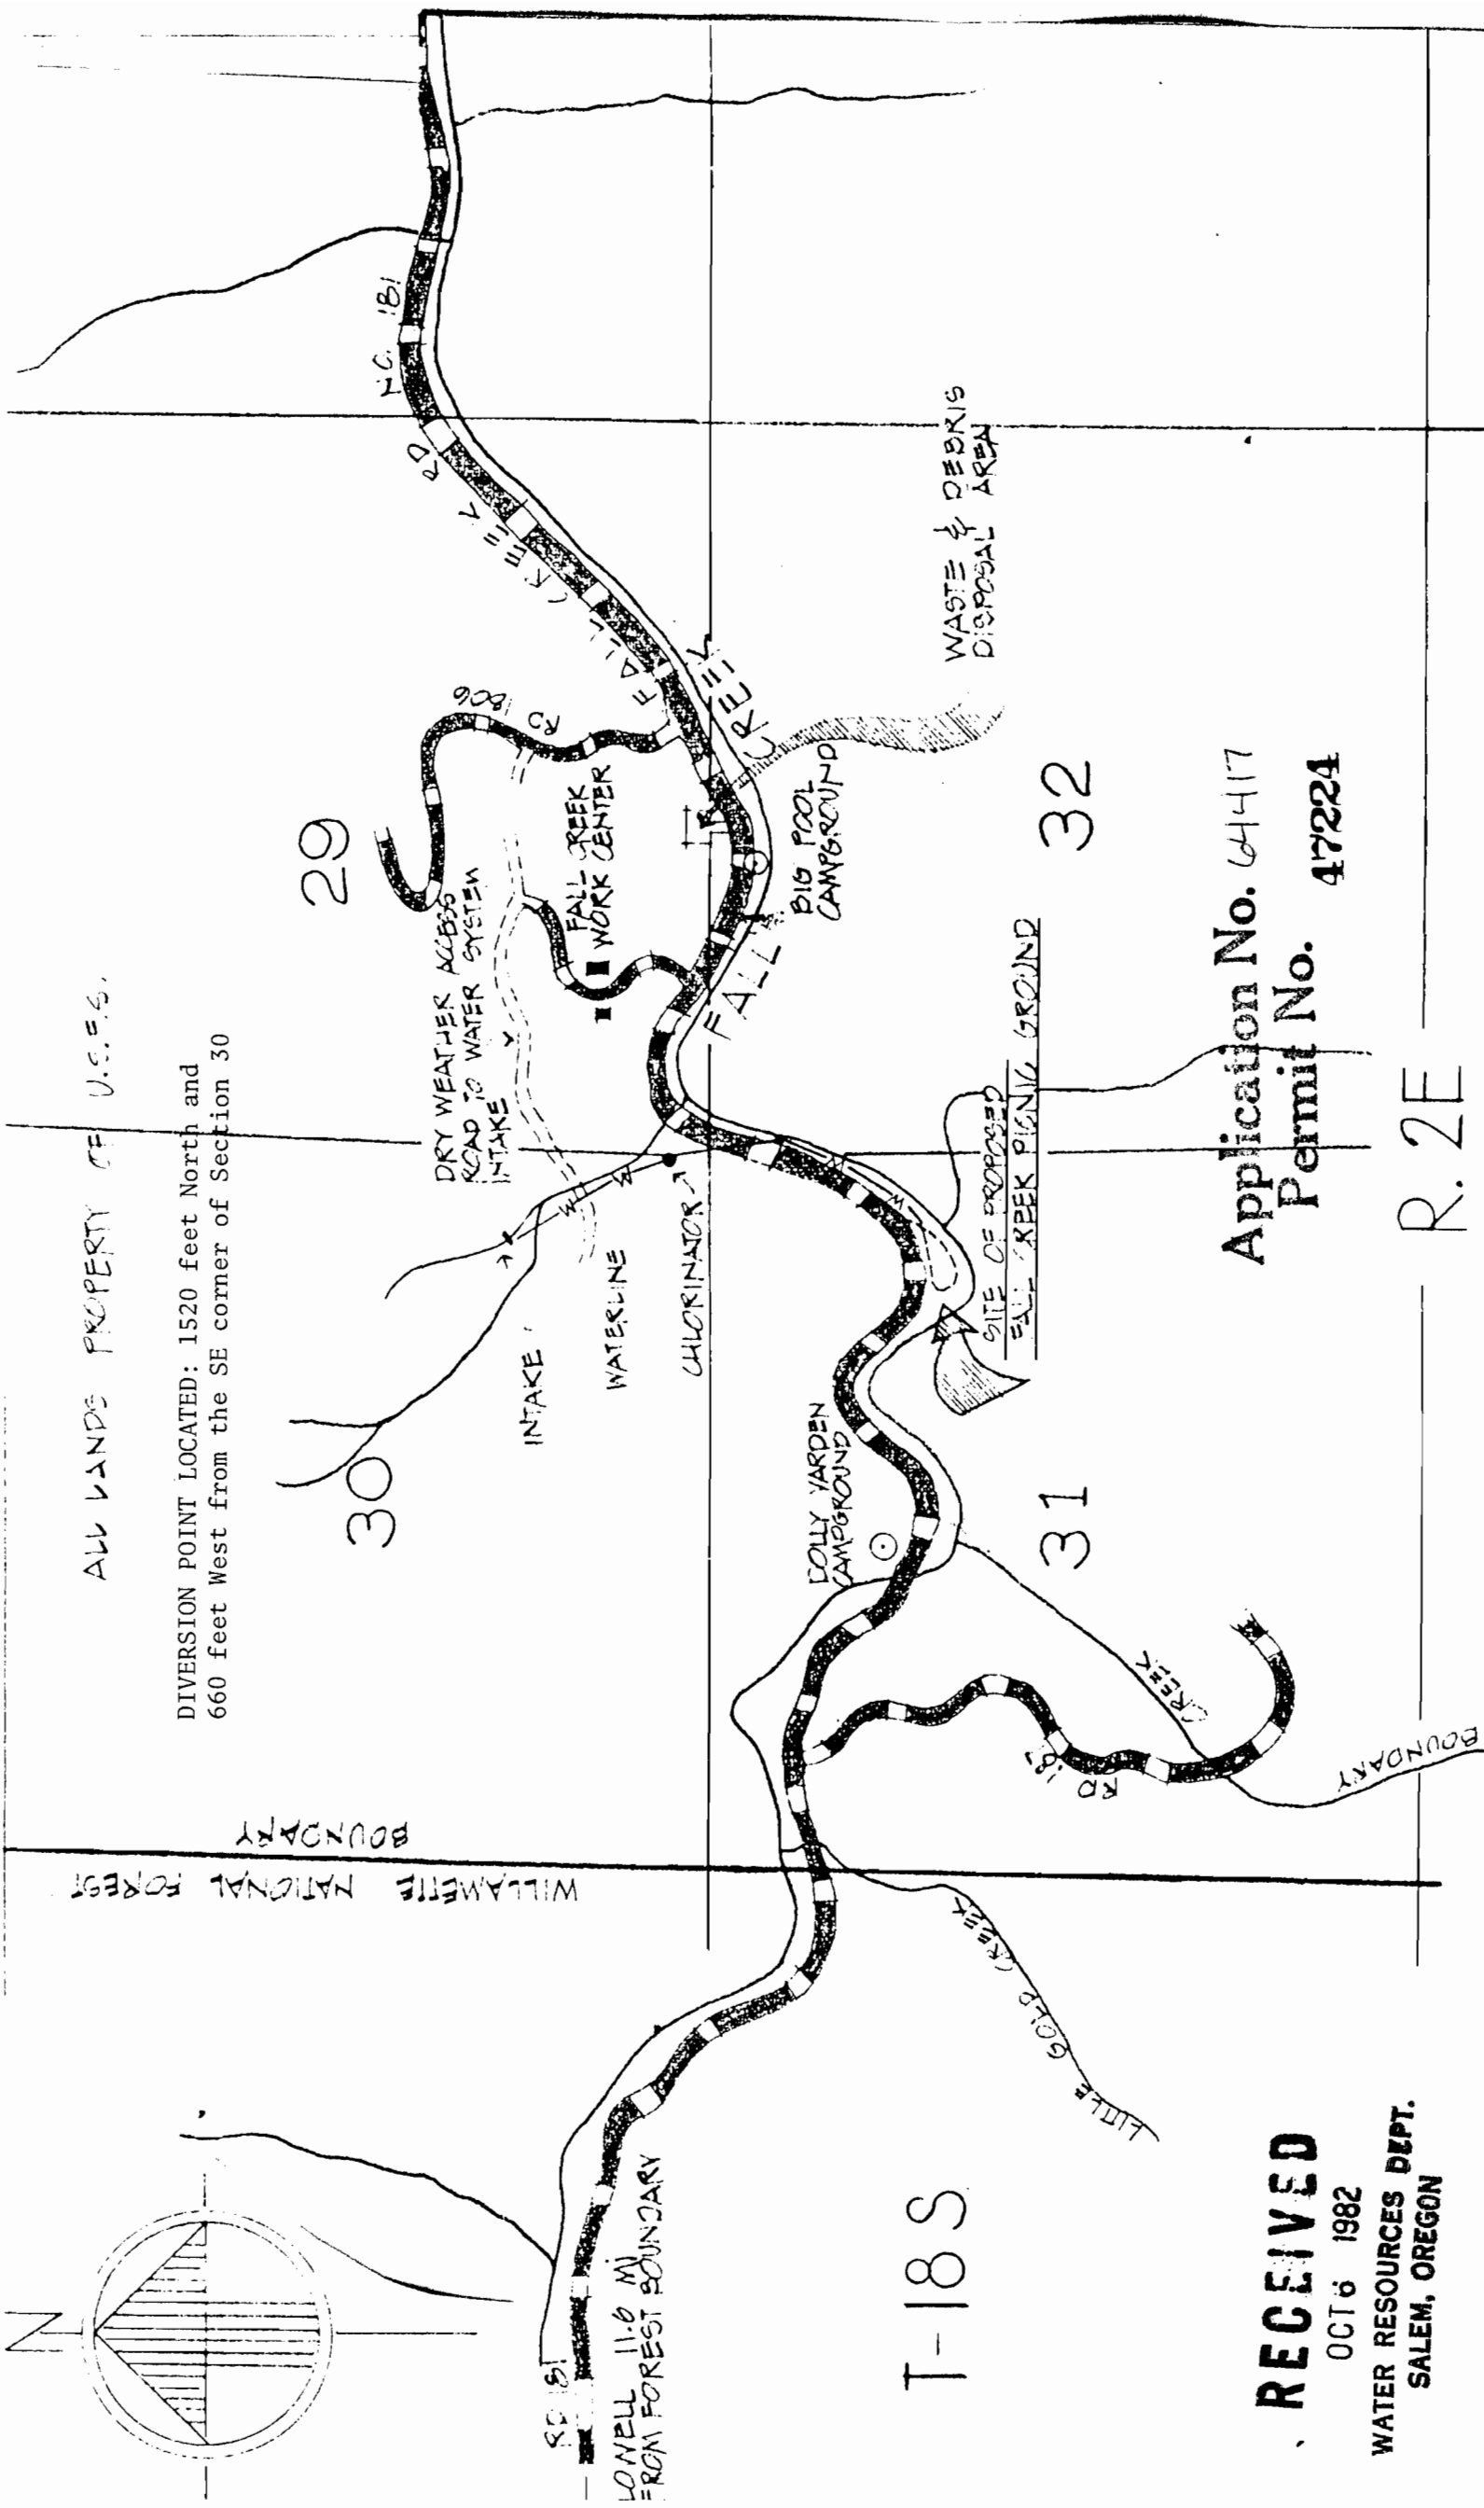

29

30

31

32

SE 1/4

LOWELL 11.6 MI FROM FOREST BOUNDARY

INTAKE

WATERLINE

CHLORINATOR

DRY WEATHER ACCESS ROAD TO WATER SYSTEM INTAKE

FALL CREEK WORK CENTER

FALL CREEK

DOLLY YARDEN CAMPGROUND

BIG POOL CAMPGROUND

RD 181

RD 181

N.G. 181

WASTE & DEBRIS DISPOSAL AREA

SITE OF PROPOSED FALL CREEK PICNIC GROUND

T-18 S

Application No. 64417  
Permit No. 47224

**RECEIVED**  
OCT 6 1982  
WATER RESOURCES DEPT.  
SALEM, OREGON

R. 2E