




T. 30 S., R. 15 W., W.M.

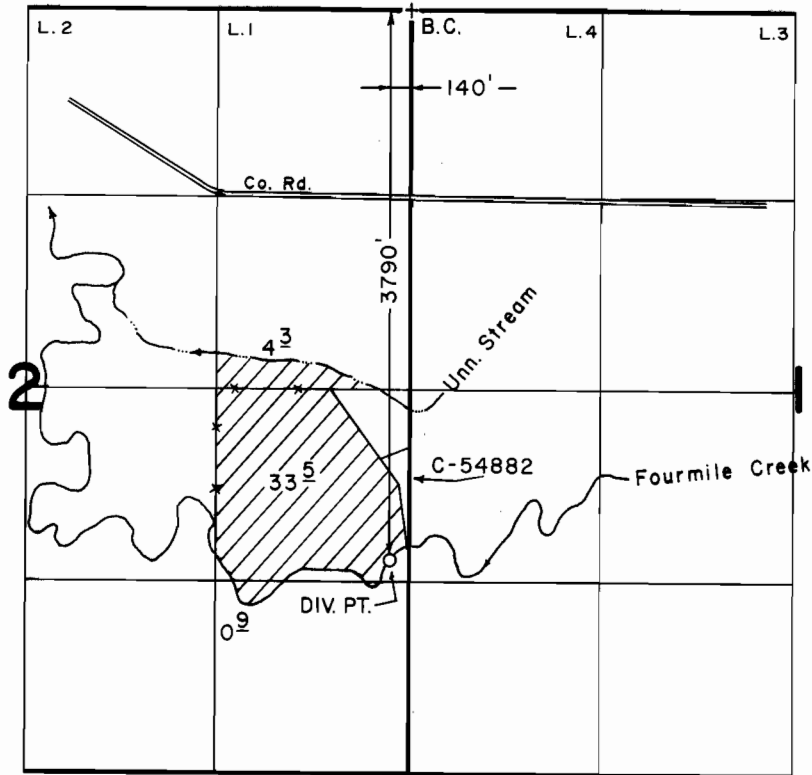

SCALE: 1" = 1320'

FINAL PROOF SURVEY UNDER

Application No. 68474.. Permit No. 49682.....
IN NAME OF

.....**FRED BUSSMANN**.....

Surveyed **APRIL 12 1990**, by **B. S. JAMES**.....