
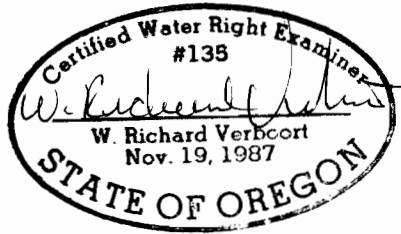


SEC. 25 & 26, T.1 S., R.5 W., W.M.  
 FINAL PROOF SURVEY  
 UNDER  
 APPLICATION 69483 PERMIT No. 50380

IN NAME OF  
 BERGETTA NIXON  
 SURVEYED JULY 18, 1989  
 REF. WASHINGTON CO. TAX LOT MAP 15 5 26D

1790'

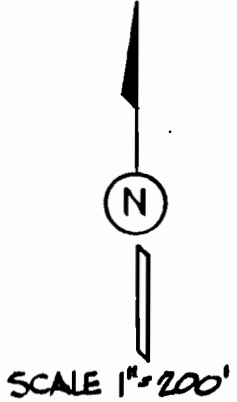

PREPARATION OF THIS MAP IS FOR THE  
 PURPOSE OF IDENTIFYING THE LOCATION OF  
 THE WATER RIGHT ONLY. THERE IS NO INTENT  
 TO PROVIDE DIMENSIONS OR LOCATION OF  
 PROPERTY OWNERSHIP LINES

26 25