


T. 30 S. R. 5 W. W.M.

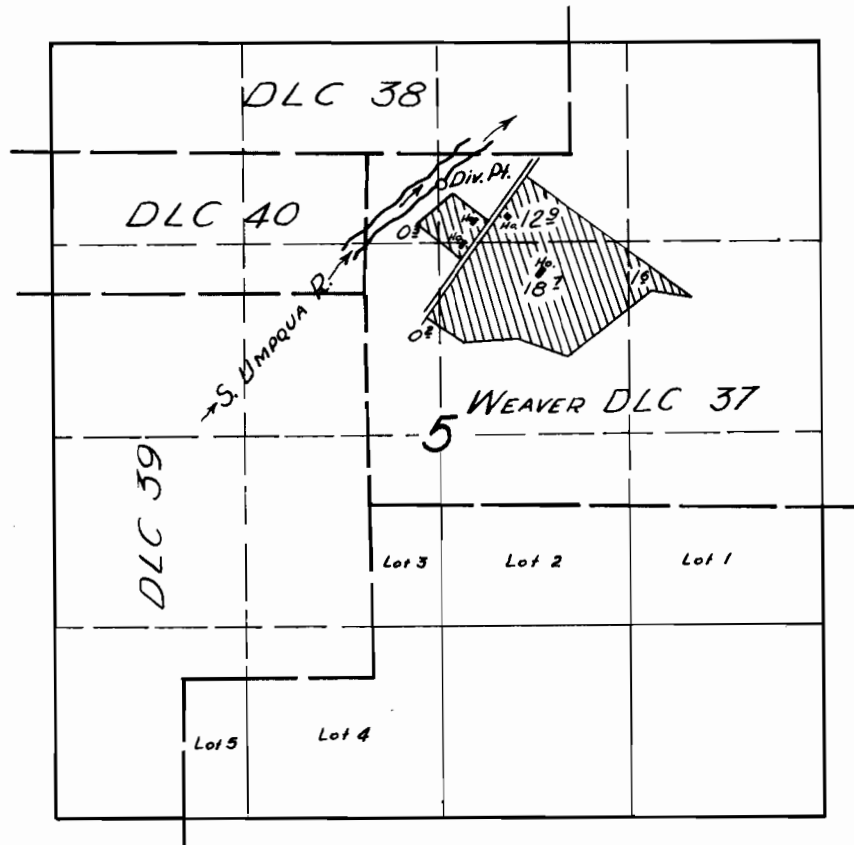

FINAL PROOF SURVEY

UNDER

Application No. 26905 Permit No. 21406

IN NAME OF

BRUCE L. WYNTER

Surveyed 4 Oct. 1956, by C. Whitby