




# T. 30 S., R. 14 & 15 W., W.M.

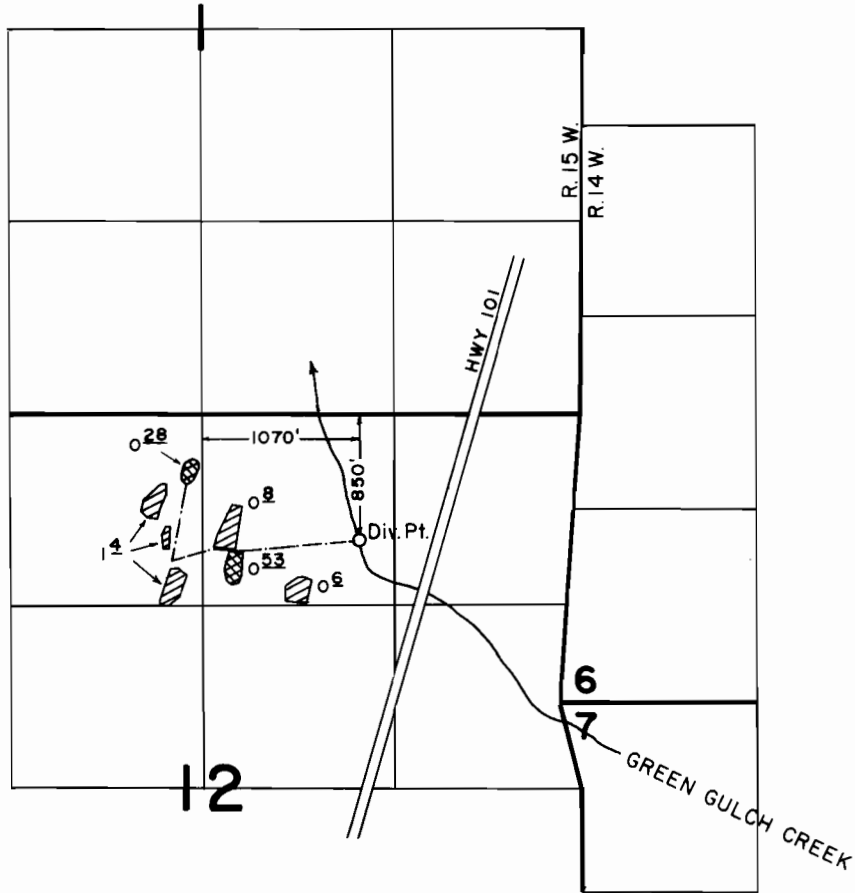

SCALE: 1" = 1320'

## FINAL PROOF SURVEY UNDER

-  Irrigation
-  Temperature Control & Harvesting

Application No. 52521... Permit No. 41306  
IN NAME OF

**WILLIAM S. & IRIS A. LOSHBAUGH**

Surveyed JUNE 13, 1979, by J. S. DONALDSON