


T. 2S. R. 38E. W.M.

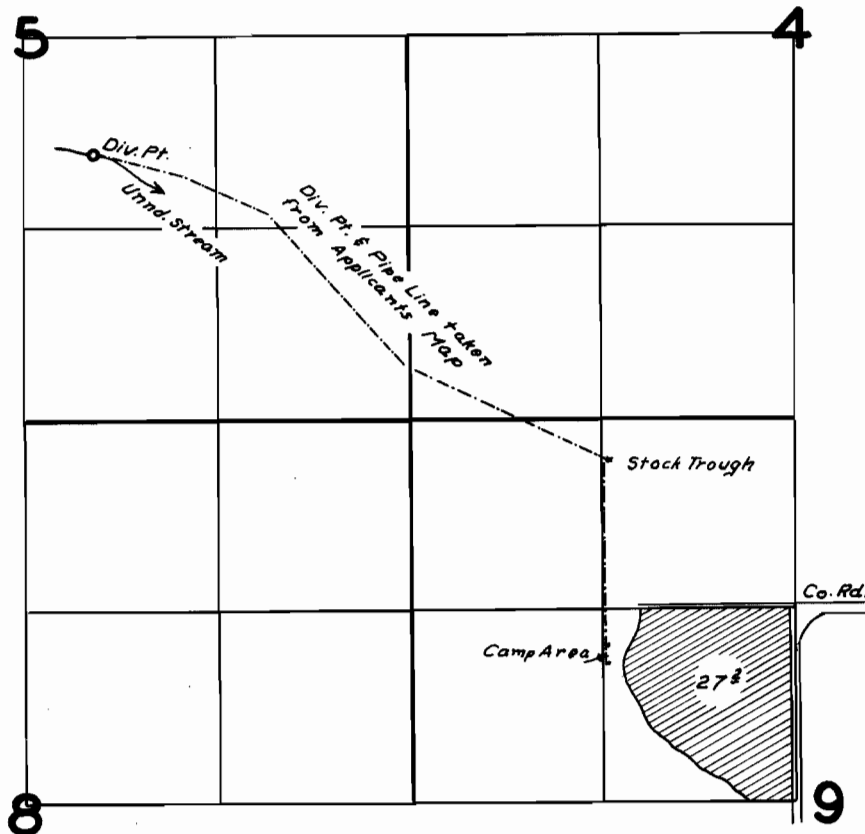

FINAL PROOF SURVEY
UNDER

Application No. 25309 Permit No. 19974
IN NAME OF

Frank E. Young

Surveyed Aug. 7, 1959, by *R. H. Jackson*