


T.16S.R.4W.W.M.

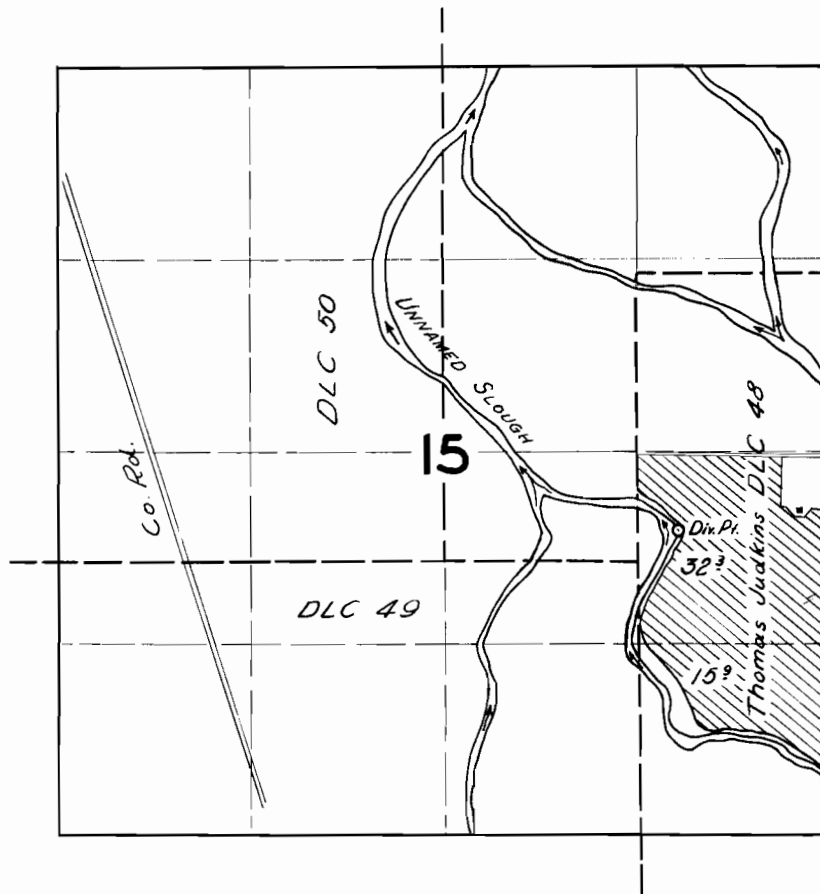

FINAL PROOF SURVEY
UNDER

Application No. 24598 Permit No. 20195
IN NAME OF

JOHN T. BRICE

Surveyed 8 April 1957, by *C. A. Wilby*