


T. 38 & 39 S., R. 11 E., W.M.

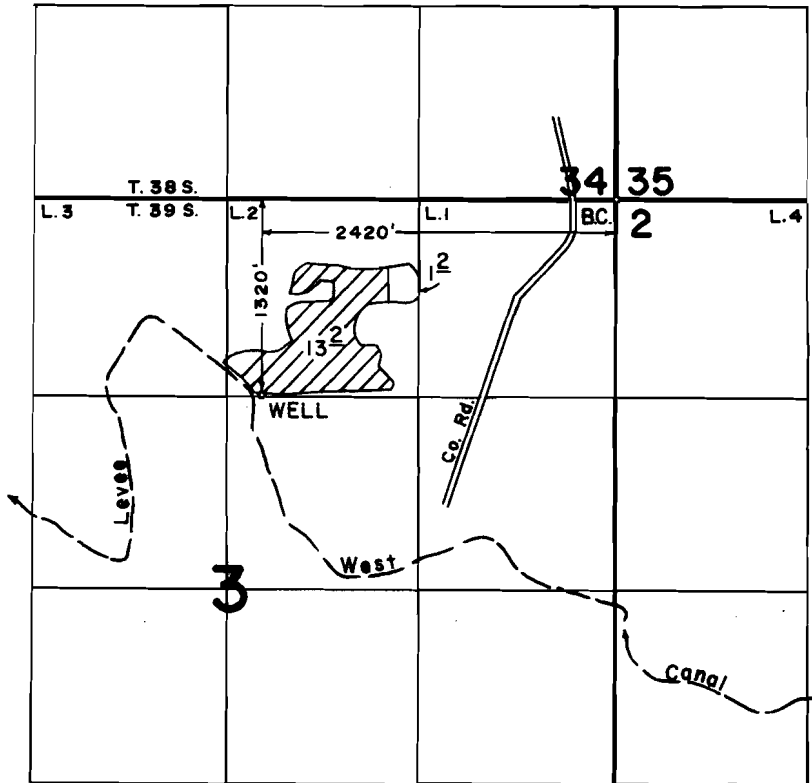

SCALE: 1" = 1320'

FINAL PROOF SURVEY UNDER

Application No. G-8679 Permit No. G-8252...
IN NAME OF

.....HOWARD T. KELLISON.....

Surveyed APRIL 12 1990, by D.W. SPARKS...

Lost the Wells