
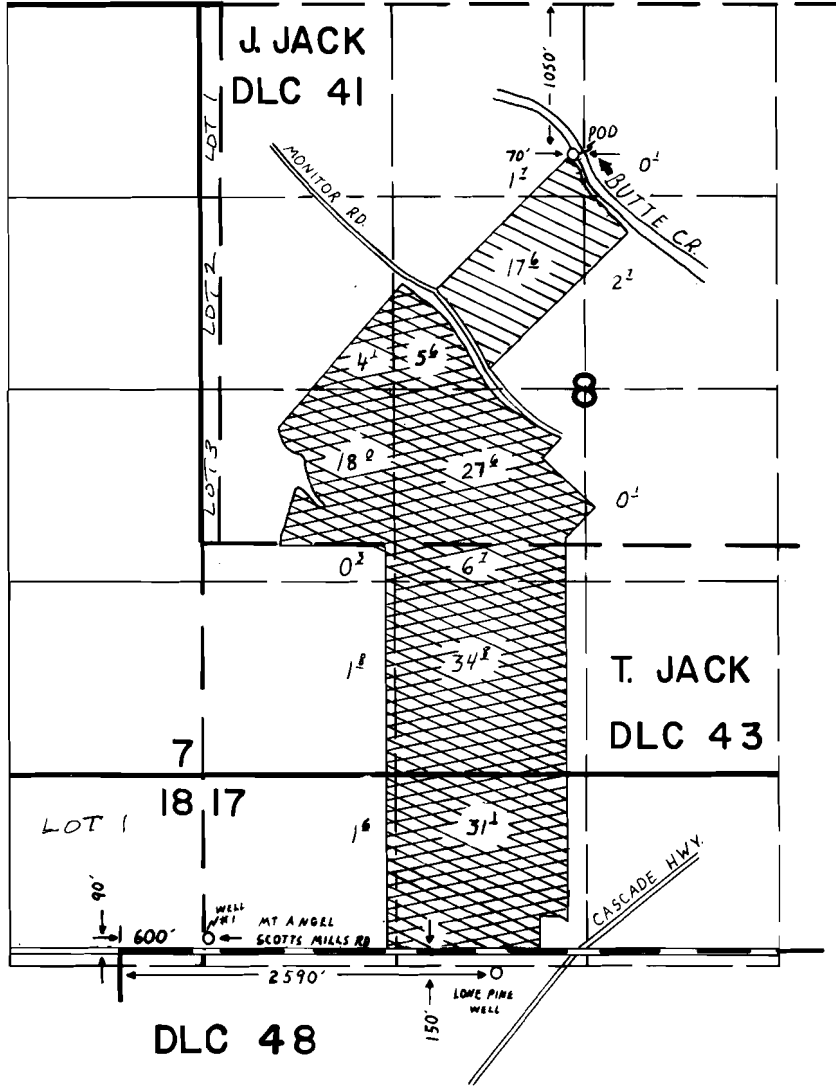



T6S, R1E, WM

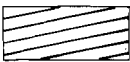

FINAL PROOF SURVEY UNDER

-  APP 60133
-  APP G-9731

G-9731 G-8954
 Application No. ~~60133~~ Permit No. ~~45090~~
 IN NAME OF

HAROLD KRAEMER

Surveyed MAY 18 1984, by B. W. BISHOP...