


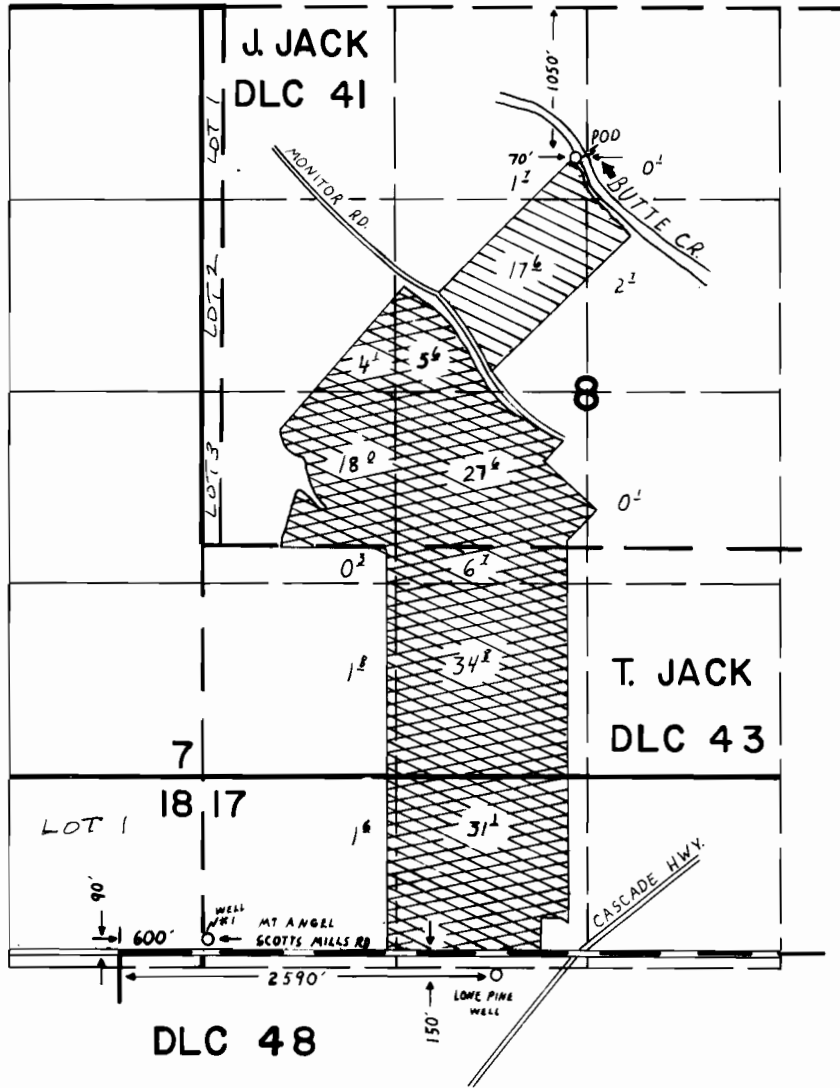

T6S, R1E, WM



FINAL PROOF SURVEY UNDER

-  APP 6-0133
-  APP G-9731

G-9731 G-8954
 Application No. 6-0133 Permit No. 45090...
 IN NAME OF

..... HAROLD KRAEMER

Surveyed MAY 18 1984, by B. W. BISHOP...