


SECTION 23,24 T3S RIW. W.M.
CLACKAMAS COUNTY

1" = 400'

INTERSTATE HWY. NO. 5

WILLAMETTE RIVER

RIVER

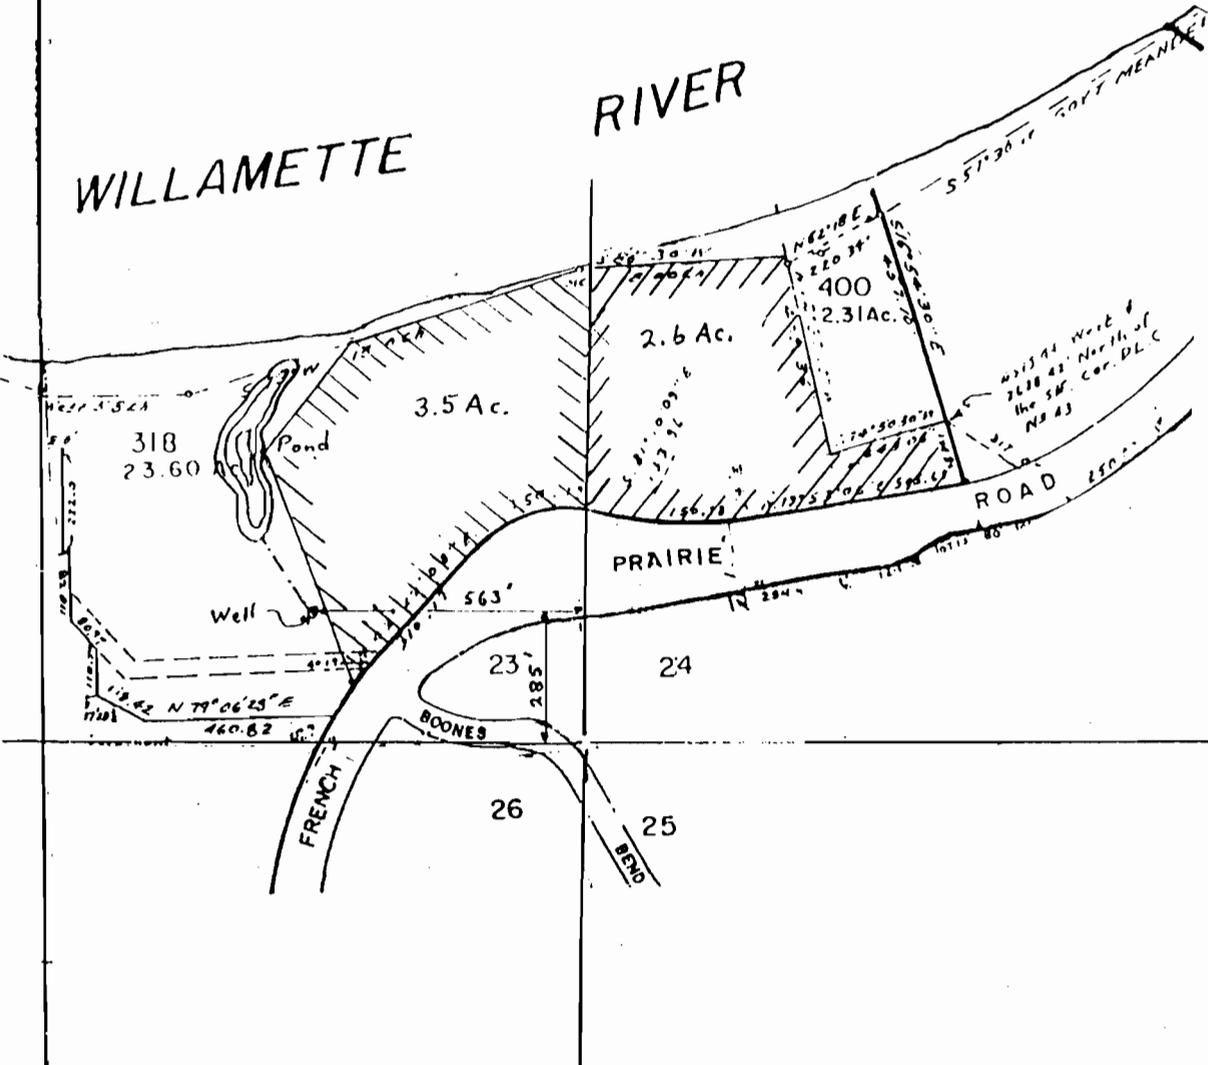


FINAL PROOF SURVEY
UNDER

Application No G11685 Permit No. G10787
IN NAME OF

COLUMBIA-WILLAMETTE DEVELOPMENT COMPANY

Surveyed JUNE 21, 1989

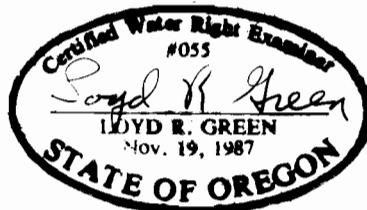

RECEIVED

JUN 29 1989

ATER RESOURCES DEPT
EM, OREGO