


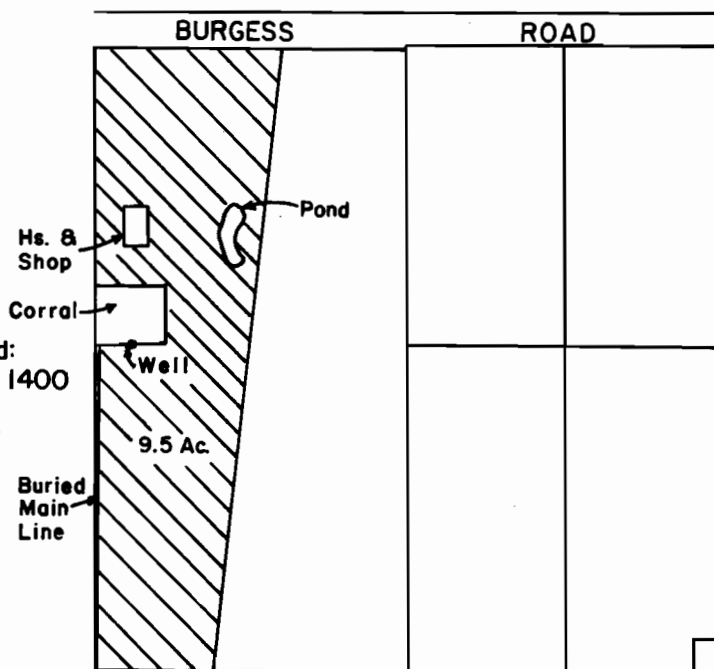

The Well is Located:
600 feet South and 1400
feet East from the
Northwest corner of
Section 3.




NE 1/4 NW 1/4, SECTION 3
TOWNSHIP 22 SOUTH,
RANGE 10 EAST,
W.M.

FINAL PROOF MAP
APPLICATION NO: G11705
PERMIT NO: 10796
FOR MARILYN J. COPELAND

I, James R. Tye, Certified Water Right Examiner
in the State of Oregon, hereby certify the above
final proof map was prepared under my direct
supervision.

The preparation of this map is for the purpose
of identifying the location of the water right
only and has no intent to provide dimensions or
locations of property ownership lines.

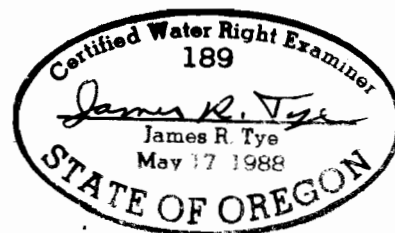

Scale 1" = 400' | Date 3-9-90 | Survey by JT & TC | Drawn by LWL | Order No. 2551

Sun Country Engineering & Surveying, Inc.
61555 SE PARRELL ROAD, BEND, OREGON 382-8882