

RECEIVED

T5S, R.1E, W.M.


LEGEND



INDICATES SUPPLEMENTAL
IRRIGATION AREA BY WELL SUPPLY.

NOTE:

PRIOR WATER RIGHT BY PERMIT
NO. R 8216 - 45427

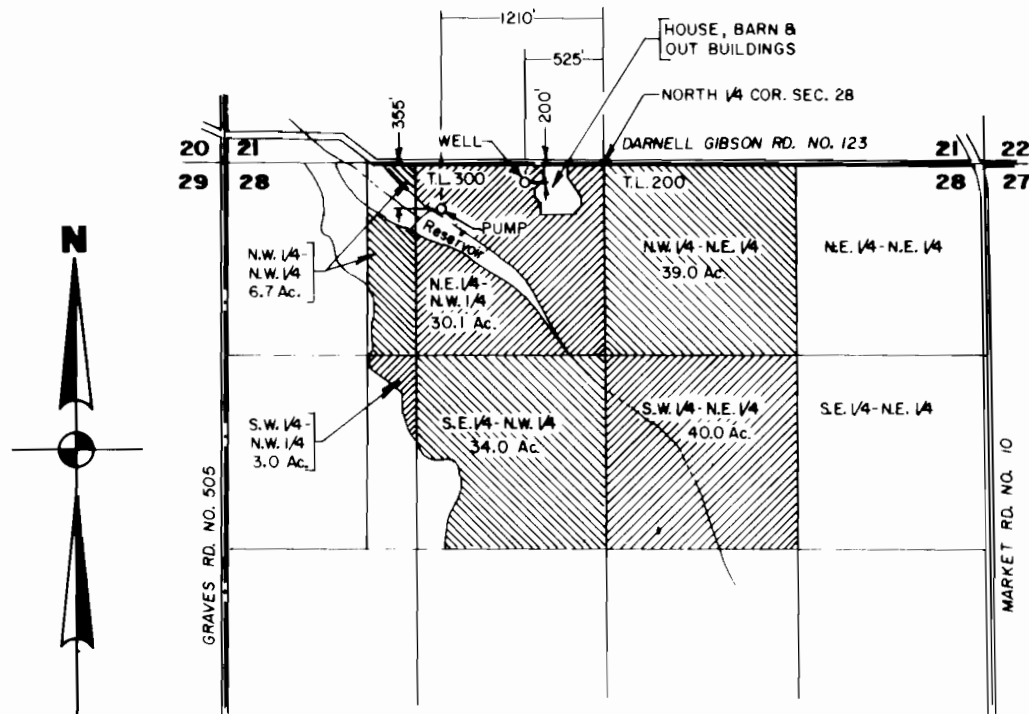

SCALE - 1" = 1320'

FINAL PROOF SURVEY

UNDER

APPLICATION NO. G-11711, PERMIT NO. G-10831

IN NAME OF

MICHAEL GASSNER

SEPT. 14, 1989

NOTE:

This map is for the purpose of
identifying the locations of the
water right only and has no
intent to provide dimensions or
location of property ownership
lines.

Registered Water Right Examiner
#128
Ronald A. Sator