


T. 26 S., R. 6 & 7 W., W.M.

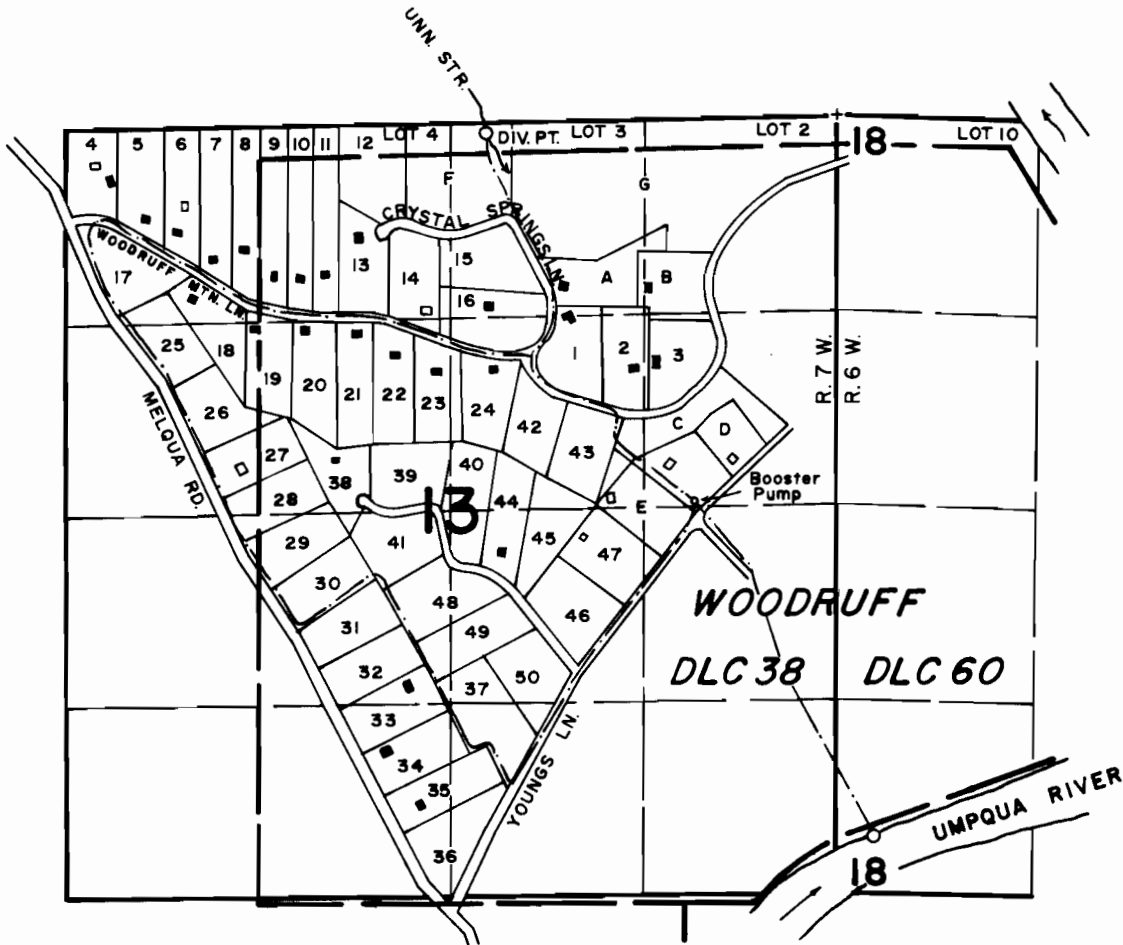

DIV. PT. LOC: UNN. STREAM - 60' S. & 240' E. FROM N. 1/4 CORNER SECTION 18., T. 26 S., R. 7 W., W.M.

SCALE: 1" = 1320'

**FINAL PROOF SURVEY
UNDER**

■ ALLOWED
□ NOT ALLOWED

Application No. 47172.. Permit No. 35314.....
IN NAME OF

RIVER BEND WEST WATER ASSOCIATION

Surveyed MARCH 24 1980., by S. DONALDSON

Revised 5-22-90

Doug. Co. 78-22A-67