T. 18S., R. 42 & 43E., W.M.

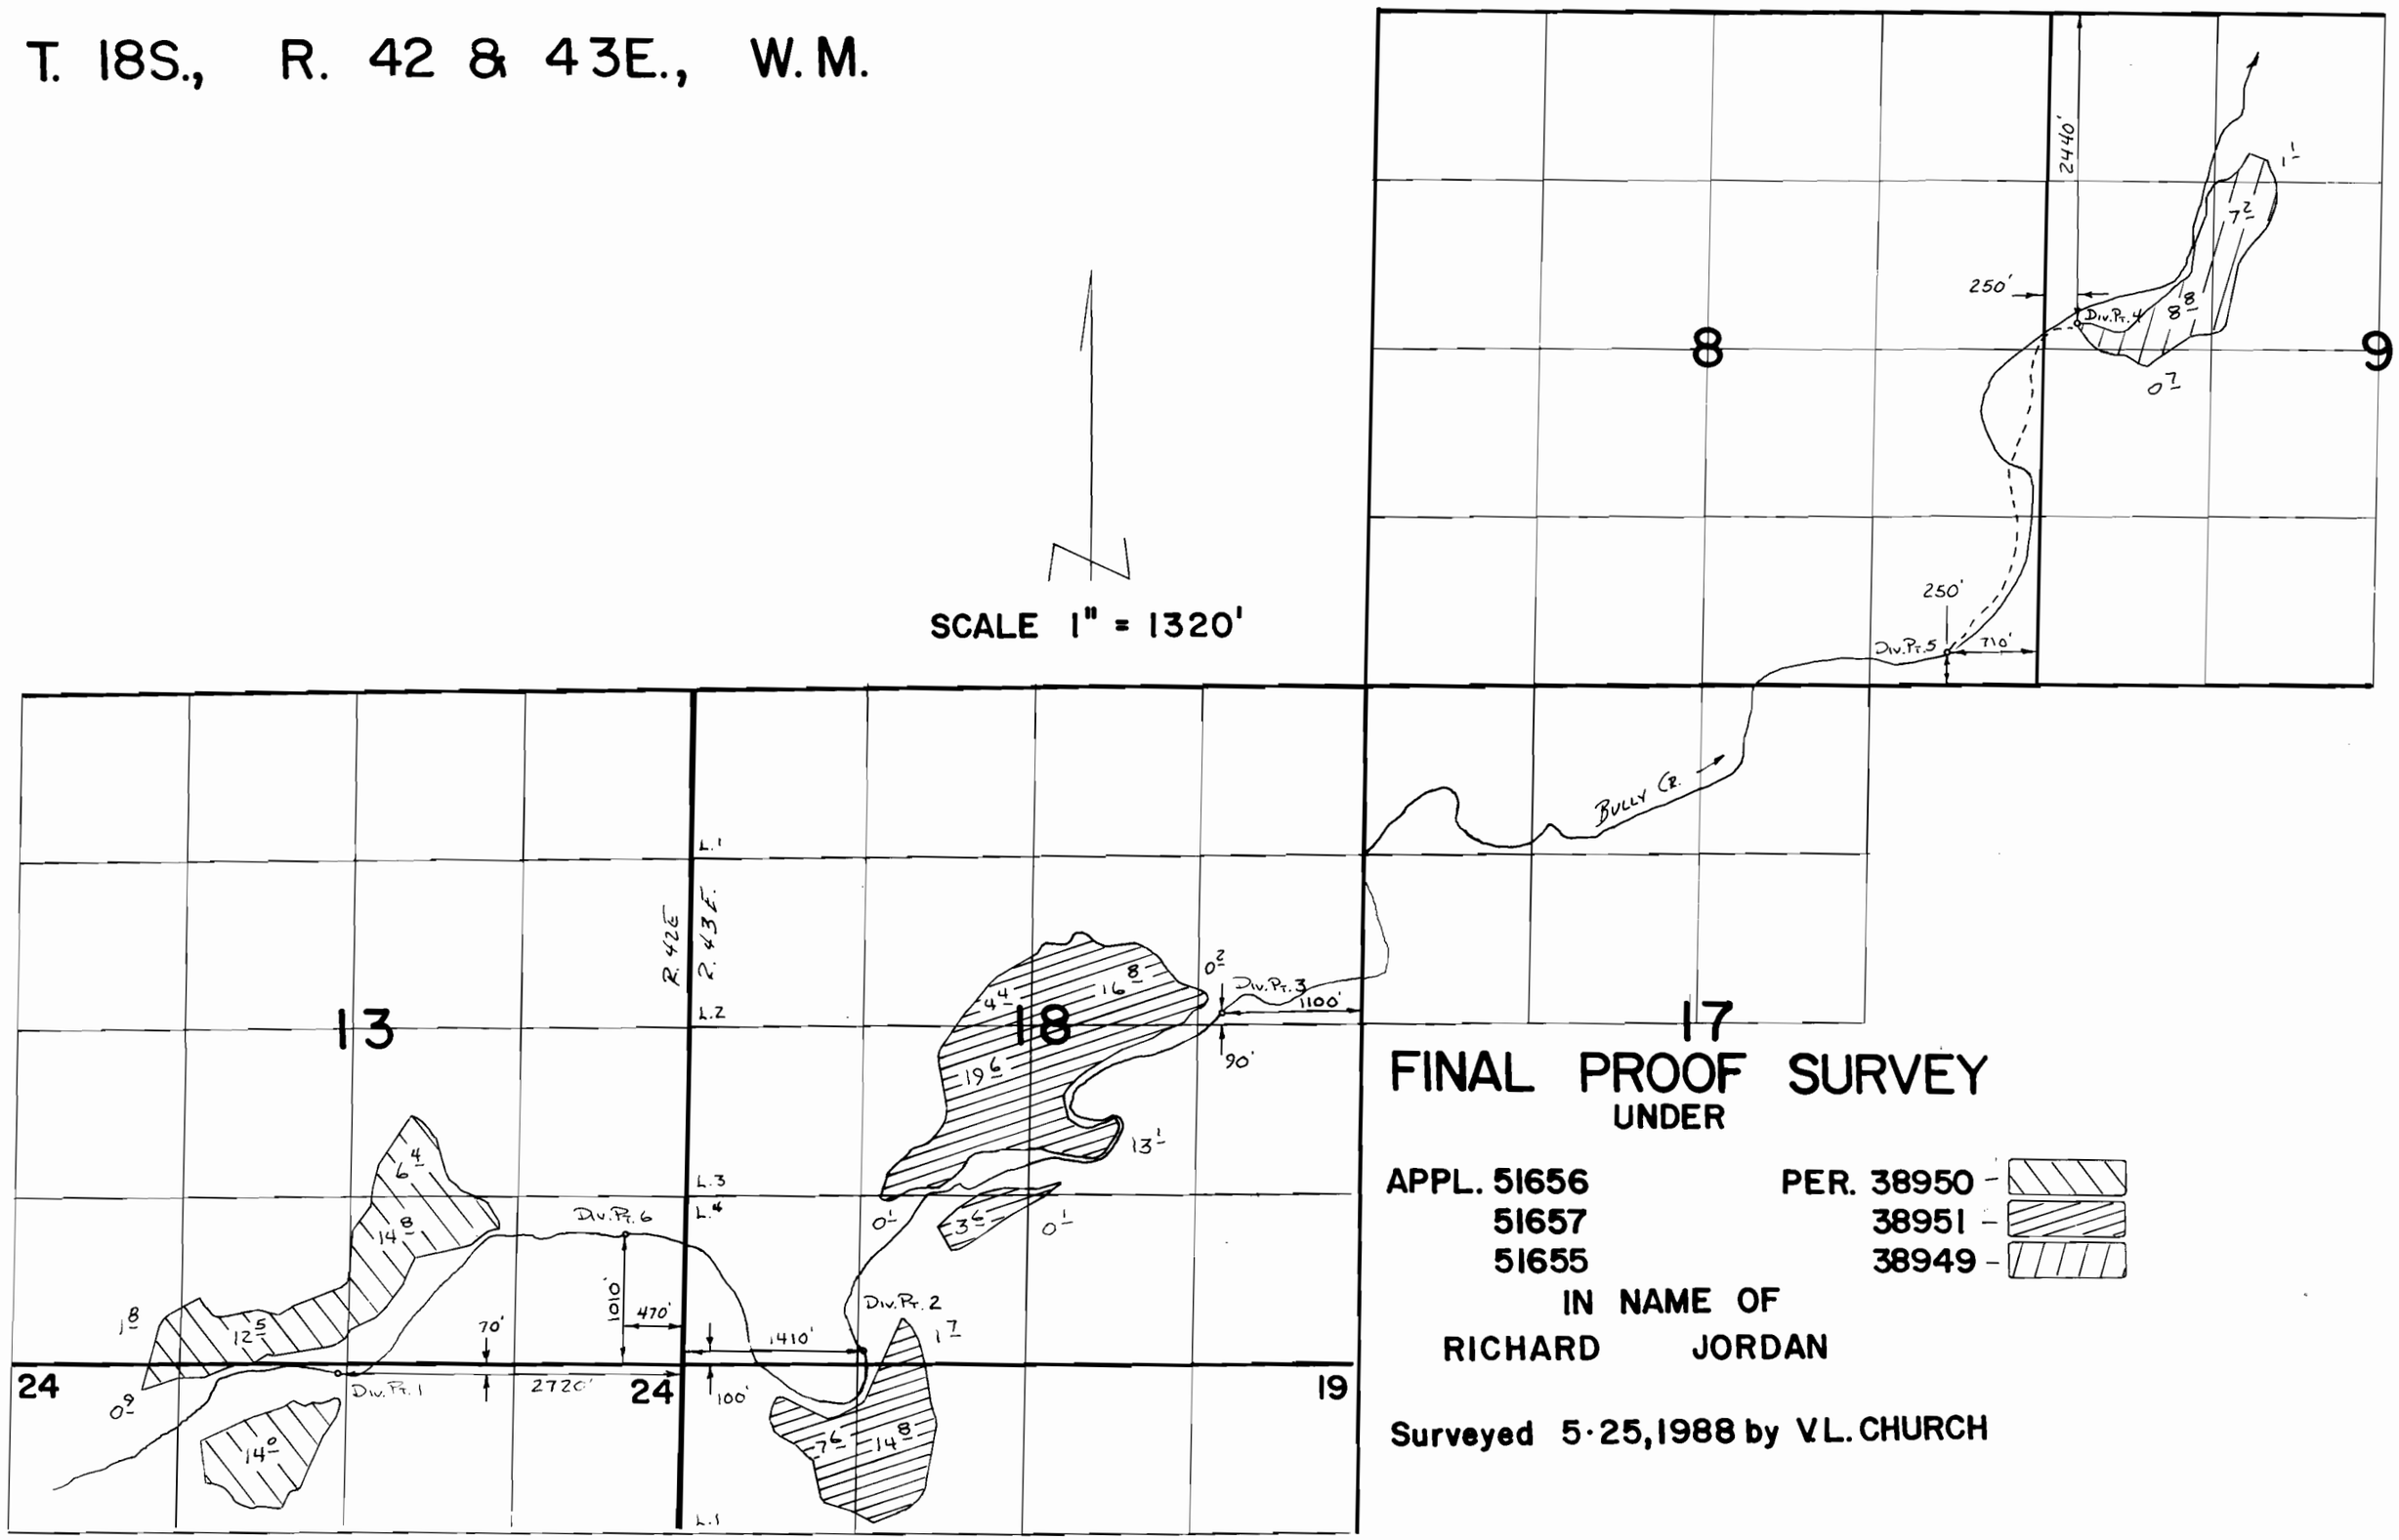


# FINAL PROOF SURVEY
UNDER

APPL. 51656
51657
51655

PER. 38950 -
38951 -
38949 -

IN NAME OF
RICHARD JORDAN

Surveyed 5·25,1988 by V.L. CHURCH

41045-178-101R, 102R 2-21-89 VLC