



T. 18S., R. 42 & 43E., W.M.

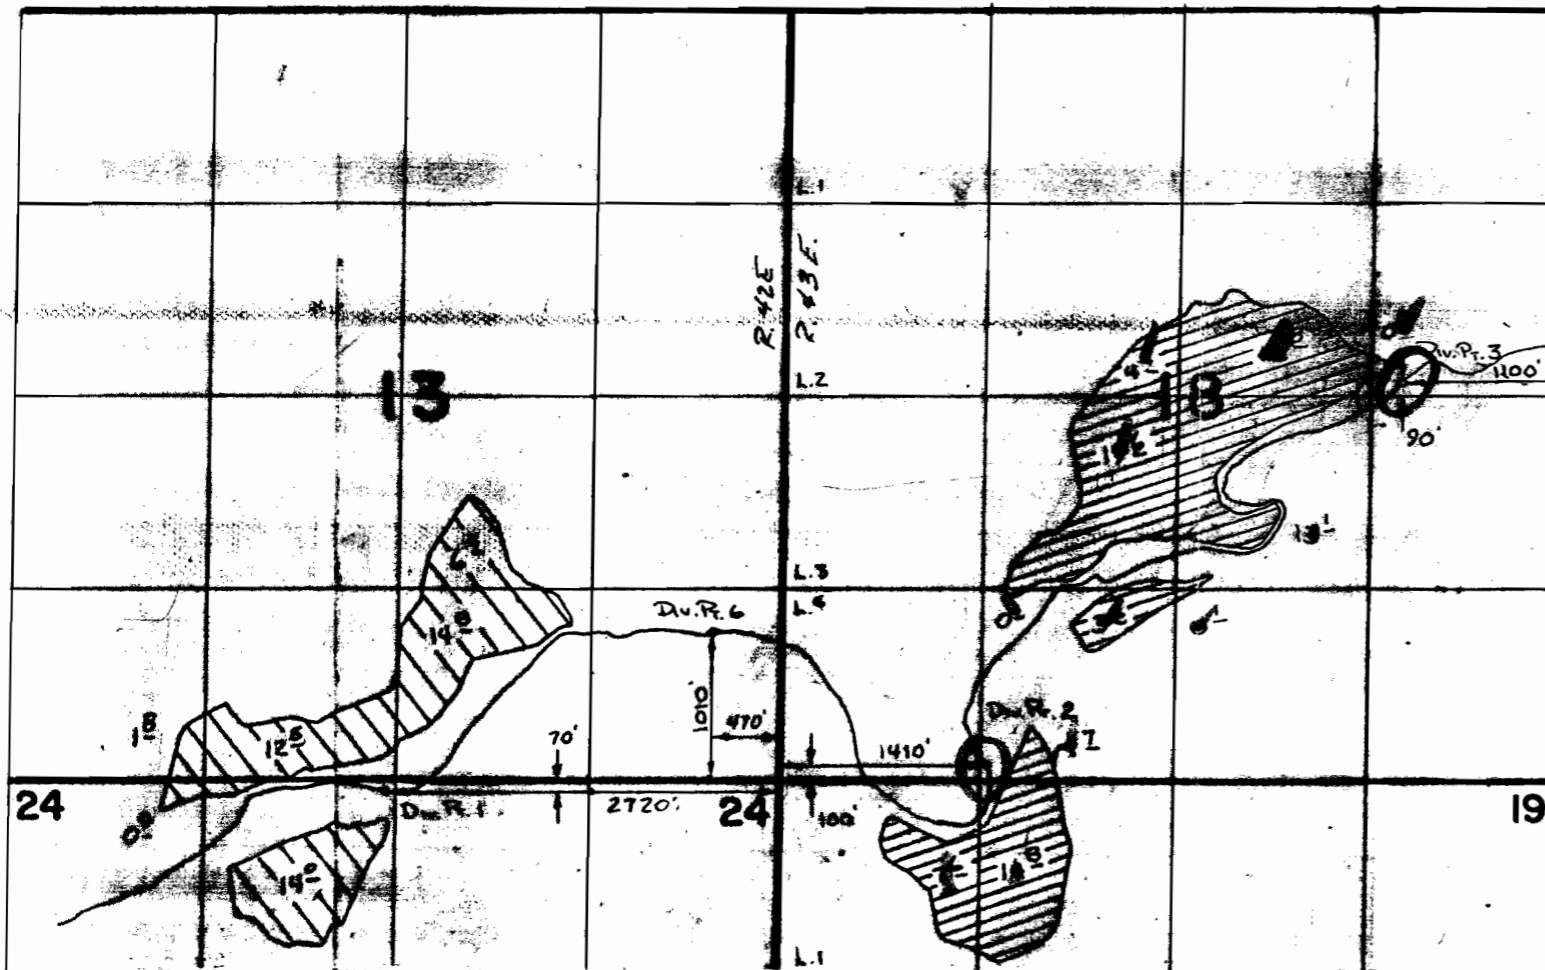


SCALE 1" = 1320'

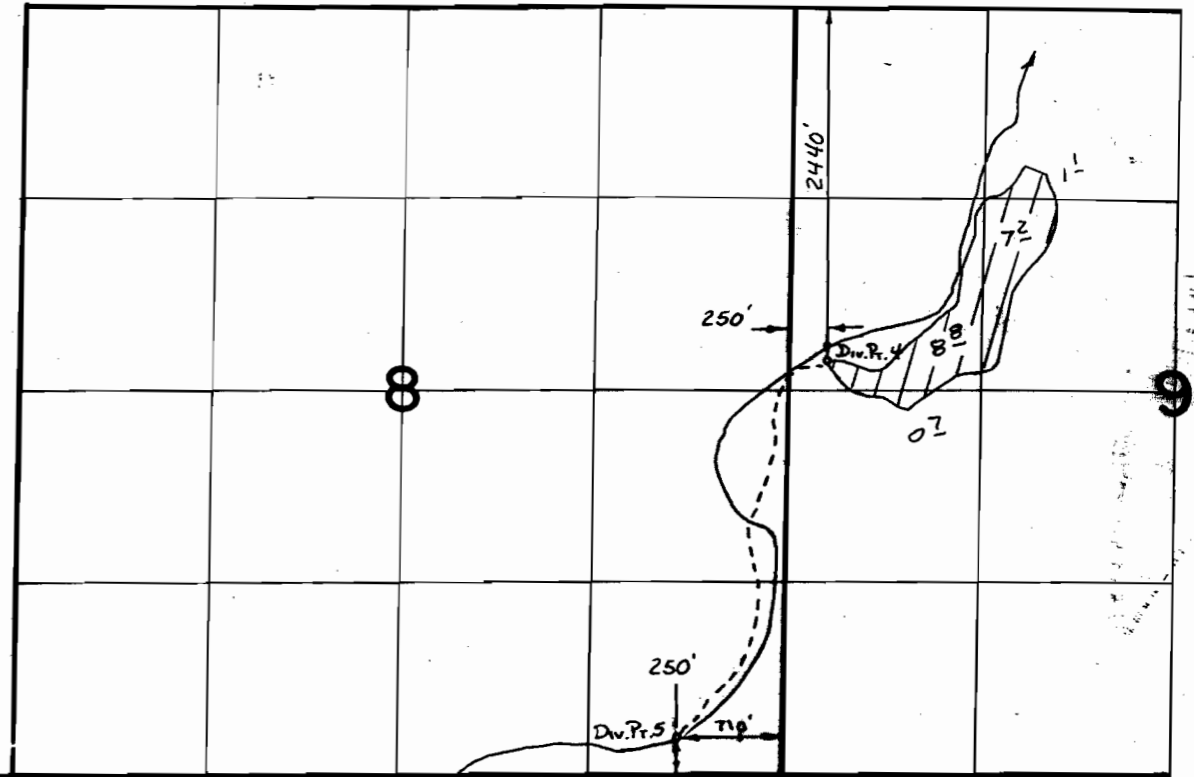

FINAL PROOF SURVEY
UNDER

APPL. 51656
51657
51655

PER. 38950
38951
38949

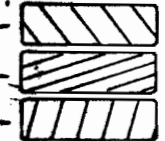

IN NAME OF
RICHARD JORDAN

Surveyed 5-25, 1988 by V.L. CHURCH