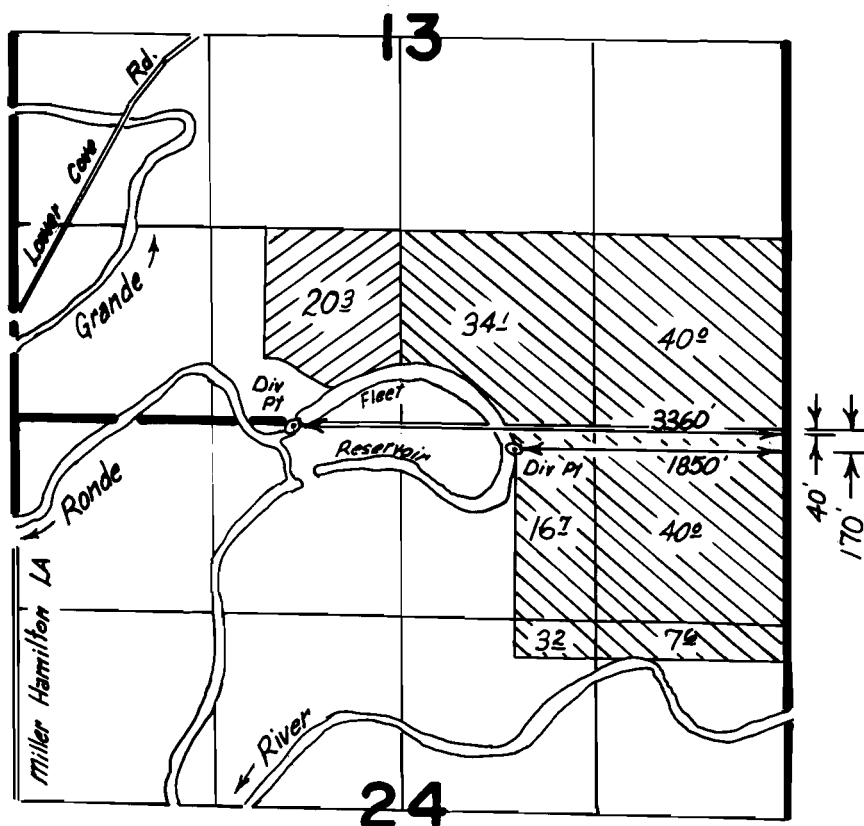


Scale: $1'' = 1320'$

FINAL PROOF SURVEY

UNDER

R-52211 R-6292
Application No. **52212**... Permit No. **39308**....
IN NAME OF

.....DUANE & LILLA FLEET.....

Surveyed ..5-5..... 19.8.7, by ...Vern...Church...

 Primary Irrigation
 Supplemental Irrigation