


T.2S., R.39E., W.M.

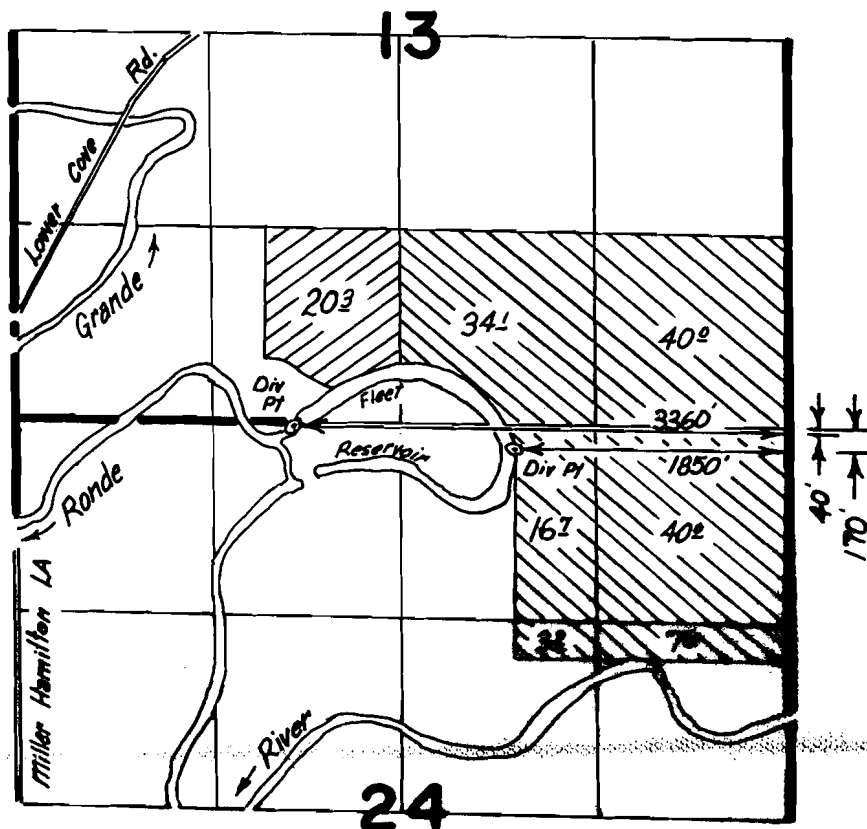

FINAL PROOF SURVEY

UNDER

Scale : 1" = 1320'

R-52211 R-6292
Application No. **52212** Permit No. **39308**
IN NAME OF

.....DUANE & LILLA FLEET.....

Surveyed 5-5..... 1987, by Yern Church...

 Primary Irrigation
 Supplemental Irrigation