T. 34S., R. 8W., W.M.

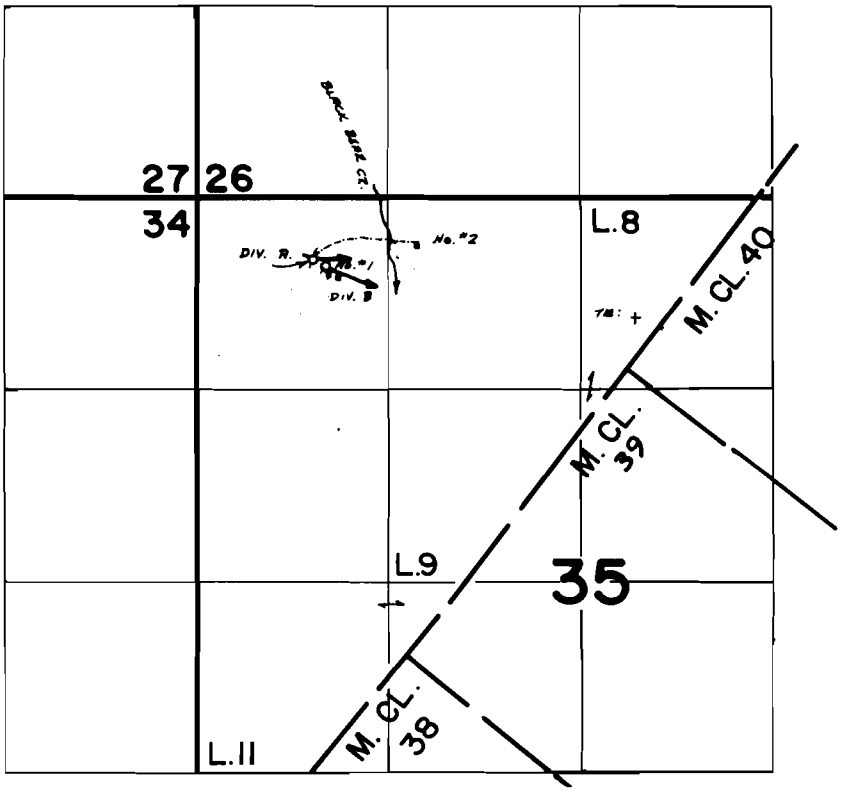

Scale = 1" = 1320'

DIV. A : 400'S & 800'E ; DIV. B, : 450'S & 880'E
BOTH FROM NW COR. OF SEC. 35.

FINAL PROOF SURVEY
UNDER

Application No. 52268 Permit No. 39332
IN NAME OF

ROBERT W. RADCLIFF

Surveyed JUNE 26 1984, by B.S. JAMES

41033-170-204L

REVISED 11/93 BSJ