


T 15., R. 43E., W.M.

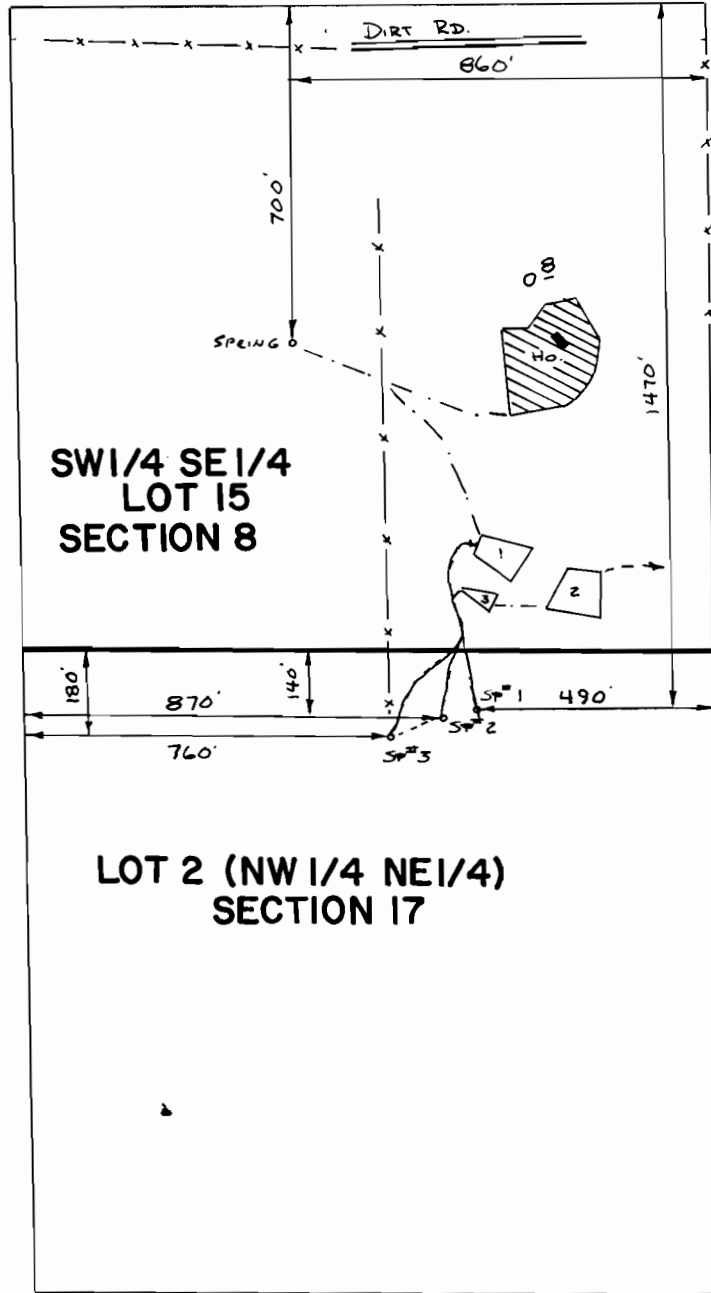

SCALE 1" = 1320'

FINAL PROOF SURVEY UNDER

R-52825 R-6322

Application No. **52681** ... Permit No. **39461** ...

IN NAME OF

..... **LARRY A. MILLER**

Surveyed **8-8** 19**88**, by