


T.6S., R.41E., W.M.

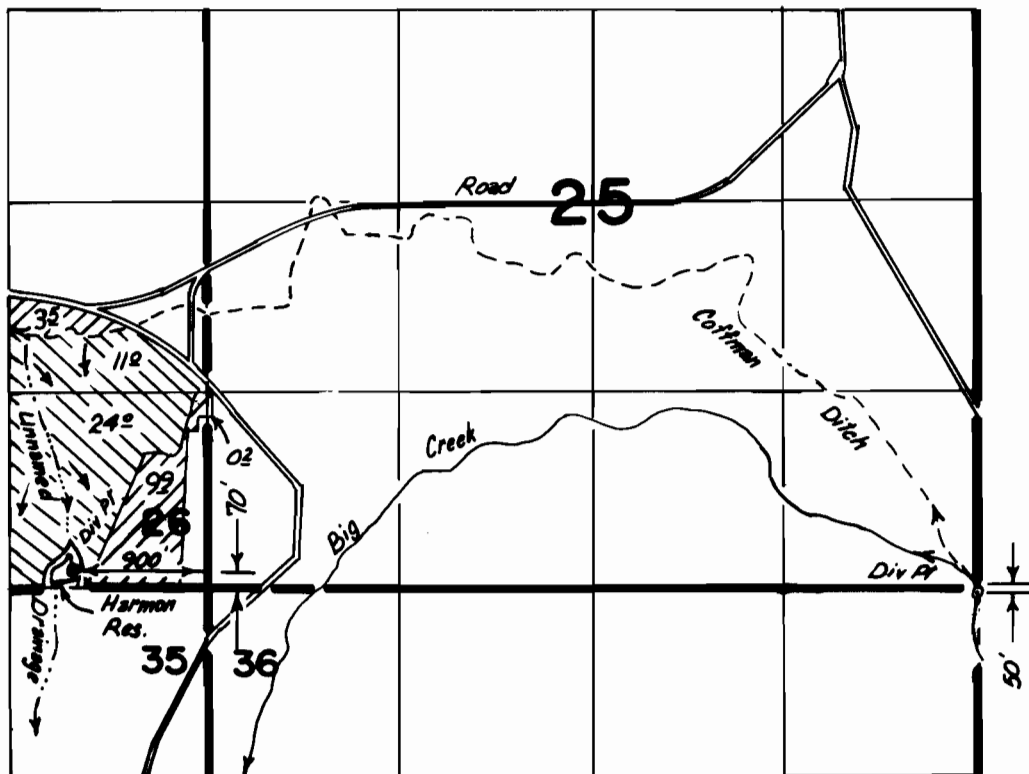



FINAL PROOF SURVEY

UNDER

Scale: 1" = 1320'

R-53624 R-6406
 Application No. 53625 Permit No. 40115
 IN NAME OF

-  Primary Irrigation
-  Supplemental Irrigation

PHILLIP W. WHITLEY

Surveyed ...7-28... 1988., by ..Kern..Church..