



T.6S.,R.41E.,& T.7S.,R.41E.,W.M.

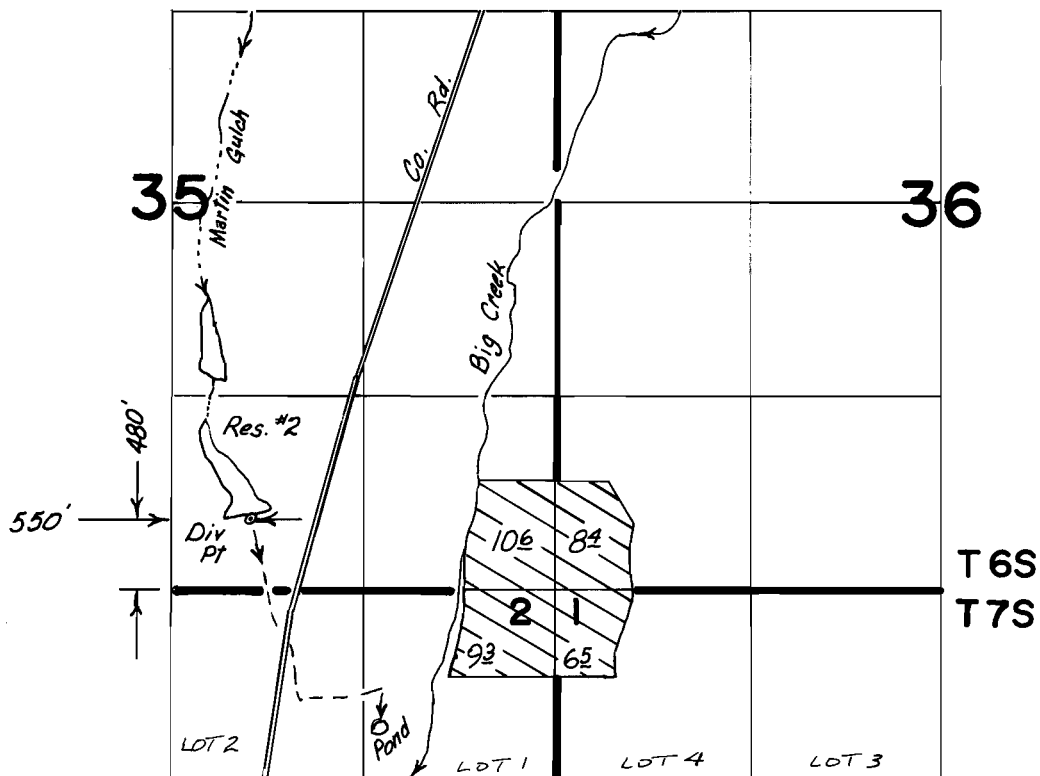

T 6S
T 7S

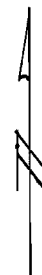

Scale: 1" = 1320'

FINAL PROOF SURVEY UNDER

R- 54237 R-6521
 Application No. **54238** Permit No. **40908**....
 IN NAME OF

CHARLES F. GREY

Surveyed ...7-28... 1988., by ..Vern..Church.....