


T. 17 S., R. 20 E., W.M.

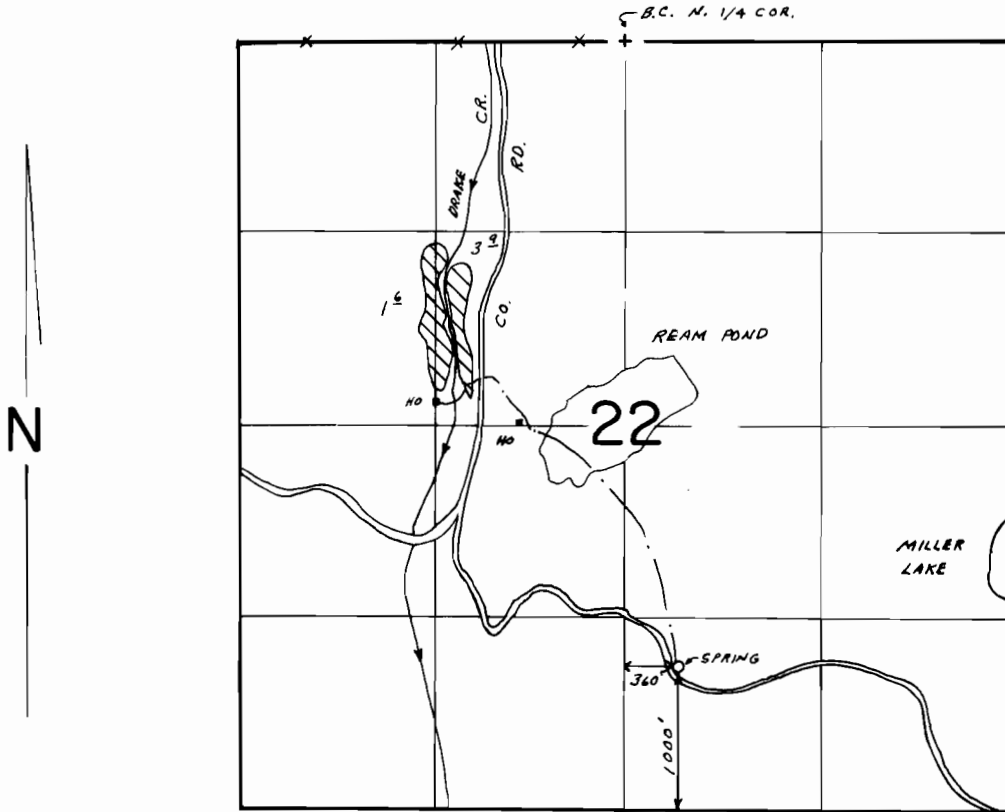

SCALE: 1"=1320'

FINAL PROOF SURVEY
UNDER

Application No. 54688 Permit No. 41031.....
IN NAME OF

.....RONALD A. McCULLOUGH.....

Surveyed AUG. 2... 1988, by B. BISHOP.....