


# T. 34 S., R. 7 E., W. 11 E.

## NE 1/4 NE 1/4 SEC. 34

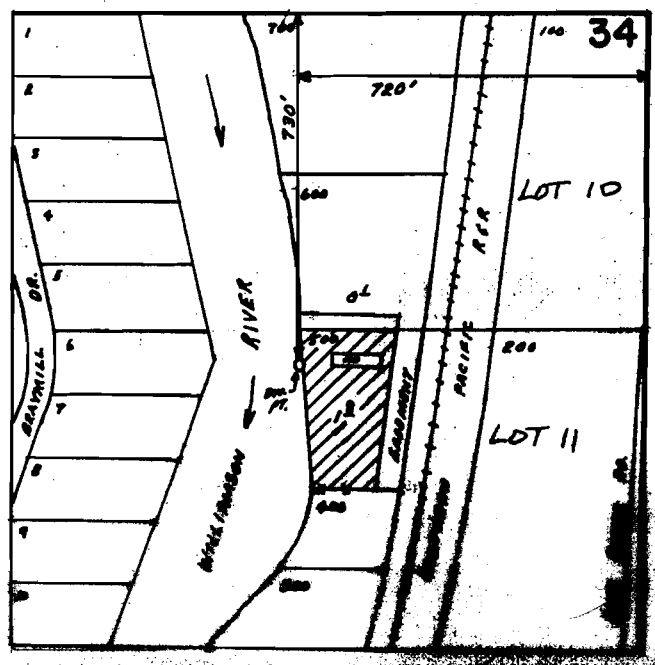

SCALE: 1" = 400'

### FINAL PROOF SURVEY UNDER

Application No. 54809 Permit No. 41119  
IN NAME OF

.....WILLIAM COREY.....

Surveyed AUG. 18 1987, by T. M. WARREN

